


CONSTRUCTION DRAWINGS  
CELLS E5 THROUGH E8  
WAIMANALO GULCH LANDFILL  
EWA BEACH, OAHU, HAWAII  
JANUARY 2010

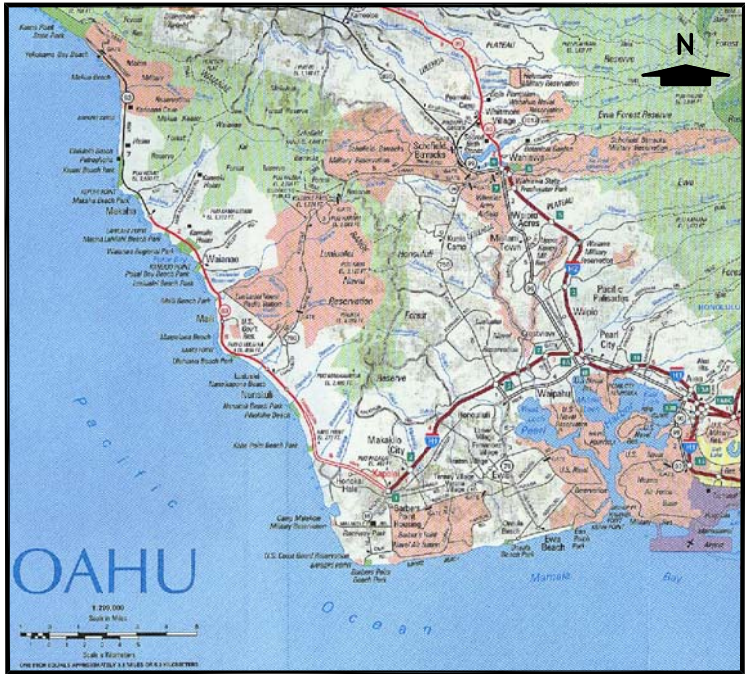

VICINITY MAP

PREPARED FOR:



WASTE MANAGEMENT OF HAWAII, INC.  
92-460 FARRINGTON HIGHWAY  
KAPOLEI, HAWAII 96707  
PHONE: (808) 640-9427

GEOSYNTEC INDEX OF SHEETS	
SHEET NO.	TITLE
1	COVER AND INDEX SHEET
2	SITE PLAN AND EXISTING TOPOGRAPHY
3	BASE GRADING PLAN AND LCRS LAYOUT IN CELLS E5-E7
4	BASE GRADING PLAN AND LCRS LAYOUT IN CELL E8
5	CONTAINMENT SYSTEM DETAILS I
6	CONTAINMENT SYSTEM DETAILS II
7	CONTAINMENT SYSTEM DETAILS III
△ 8	CONTAINMENT SYSTEM DETAILS IV
9	CONTAINMENT SYSTEM DETAILS V
10	CONTAINMENT SYSTEM DETAILS VI
11	CONTAINMENT SYSTEM DETAILS VII
12	STAGE 1 MSW PLACEMENT PRIOR TO PHASE 2 WEST BERM
13	PHASE 2 WEST BERM PRIOR TO STAGE 2 MSW PLACEMENT
14	STAGE 2 MSW PLACEMENT PRIOR TO PHASE 3 WEST BERM
15	PHASE 3 WEST BERM PRIOR TO STAGE 3 MSW PLACEMENT
16	STAGE 3 MSW PLACEMENT ABOVE CELLS E5 AND E6
△△ 17	WEST BERM FINAL COVER DETAILS I
18	CONSTRUCTION CROSS SECTION- SECTION S-1
19	CONSTRUCTION CROSS SECTION- SECTION S-2
20	CONTAINMENT SYSTEM DETAILS VIII
21	CONTAINMENT SYSTEM DETAILS IX
22	CONTAINMENT SYSTEM DETAILS X
23	CELL BOUNDARIES AND PROPOSED LINER LIMIT
△ 24	CELL E8 SUMP
△ 25	WEST BERM BUTTRESS
△ 26	SCHEMATIC PLAN VIEW OF SURFACE WATER PIPES

- △ REVISION 11 FEB 2010
- △ REVISION 11 MAR 2010
- △ REVISION 16 MAR 2010

PREPARED BY:  
Oakland  
California  
**GEI** Consultants




Geosyntec  
consultants  
engineers | scientists | innovators



GEI (WESTERN SURFACE WATER DRAINAGE) INDEX OF SHEETS	
SHEET NO.	TITLE
C-0	VICINITY/PROJECT AREA MAP AND LIST OF DRAWINGS
C-01	PROJECT NOTES
C-02	PLAN AND PROFILE OF MODIFICATIONS
C-03	PLAN AND PROFILE PERMANENT DRAINAGE STA. 0+00 TO STA. 12+00
C-04	PLAN AND PROFILE PERMANENT DRAINAGE STA. 12+00 TO STA. 27+00
C-05	PLAN AND PROFILE PERMANENT DRAINAGE STA. 27+00 TO STA. 42+00
C-06	PLAN AND PROFILE PERMANENT DRAINAGE STA. 42+00 TO STA. 57+00
C-07	PLAN AND PROFILE PERMANENT DRAINAGE STA. 57+00 TO STA. 67+00
C-08	DIVERSION STRUCTURE PLAN AND SECTIONS
C-09	TRANSITION STRUCTURE PLAN AND SECTIONS
C-10	TRANSITION STRUCTURE PLAN AND SECTIONS STA. 52+44
C-11	TYPICAL SECTIONS (SHEET 1 OF 2)
C-12	TYPICAL SECTIONS (SHEET 2 OF 2)
C-13	MISCELLANEOUS DETAILS (SHEET 1 OF 2)
C-14	MISCELLANEOUS DETAILS (SHEET 2 OF 2) AND CONSTRUCTION NOTES
C-15	TRASHRACK PLANS, SECTIONS, AND DETAILS
C-16	PLAN AND PROFILE TEMPORARY DRAINAGE STA. 0+00 TO STA. 15+00
C-17	PLAN AND PROFILE TEMPORARY DRAINAGE STA. 15+00 TO STA. 30+00
C-18	PLAN AND PROFILE TEMPORARY DRAINAGE STA. 30+00 TO STA. 45+00
C-19	PLAN AND DETAILS SURFACE DRAINAGE OF EXCAVATION BENCHES
C-20	84-INCH AND 36-INCH HDPE DETAILS IN CONCRETE LINED CHANNEL
C-21	DOWNSTEAM STILLING FACILITIES PLAN AND SECTIONS
C-22	FLIP BUCKET STRUCTURE PLAN AND SECTIONS
C-23	TEMPORARY DRAINAGE DIVERSION BERM AND INLET DETAILS



SURVEY CONTROL TABLE			
CONTROL POINT	NORTHING	EASTING	ELEVATION
BENCHMARK "C"	70534.53	458106.11	554.58
BENCHMARK "2"	71498.04	460070.34	858.69
BENCHMARK "3"	68693.03	456898.25	345.67
BENCHMARK "4"	67705.03	458206.6	288.16

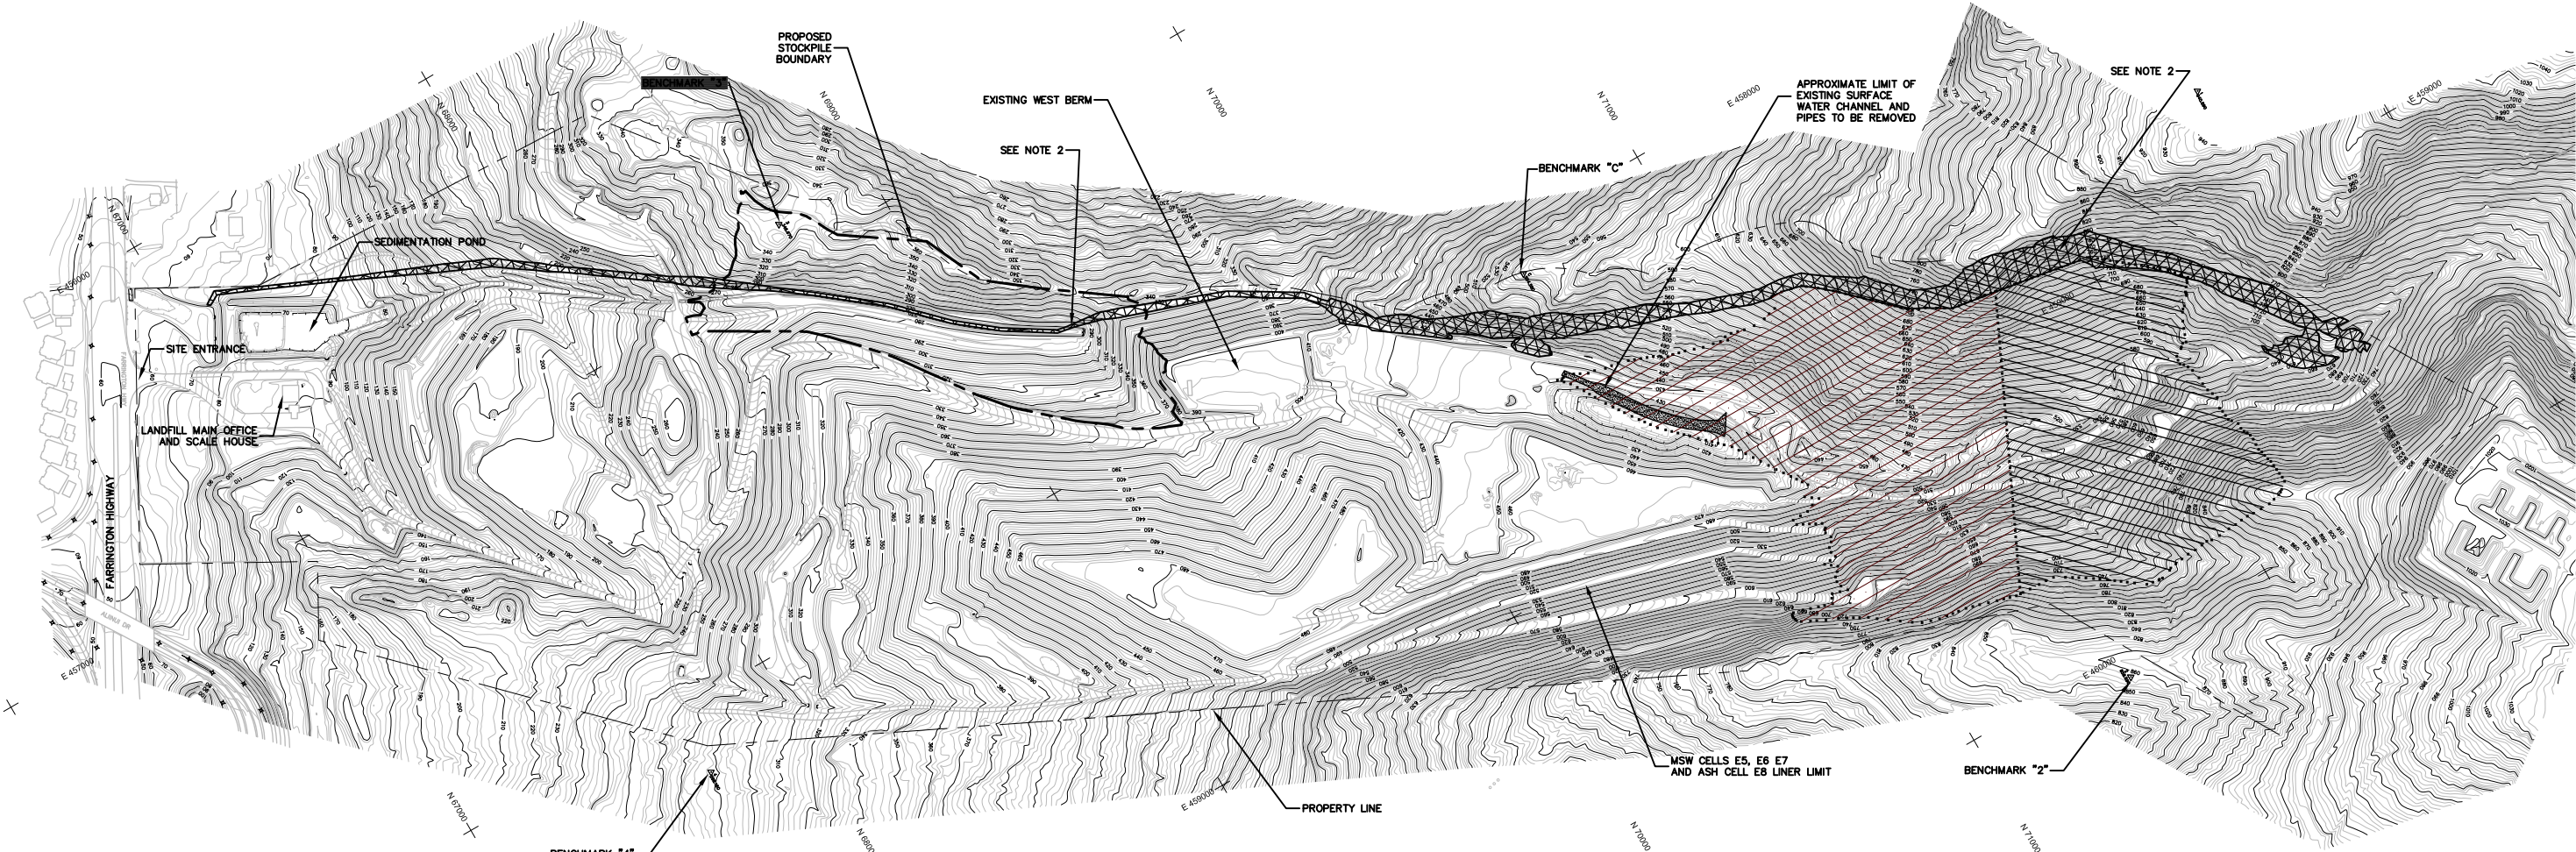

GENERAL NOTES:

- EXISTING TOPOGRAPHY BASED ON 16 MARCH 2009 AERIAL SURVEY PROVIDED BY OWNER.
- FOR WESTERN DRAINAGE IMPROVEMENTS REFER TO "WAIMANALO GULCH LANDFILL, WESTERN SURFACE WATER DRAINAGE PROJECT, EWA BEACH, OAHU, HAWAII, JANUARY 2010-CONSTRUCTION DRAWINGS", PREPARED BY GEI CONSULTANTS, INC.
- A MINIMUM OF THREE DAYS BEFORE STARTING CONSTRUCTION AND AS PART OF MOBILIZATION, CONTRACTOR WITH OWNER/OPERATOR SHALL CLEARLY MARK/IDENTIFY THE LOCATION OF EXISTING UTILITIES AND/OR FACILITIES. EXISTING UTILITIES MAY BE OVERHEAD, ABOVE-GROUND, OR BURIED. EXISTING UTILITIES INCLUDE, BUT ARE NOT LIMITED TO, OVERHEAD POWER LINES AND EXISTING FOUNDATIONS; GROUNDWATER MONITORING WELLS; LANDFILL GAS PROBES; LANDFILL GAS WELLS; SURFACE WATER SAMPLING LOCATIONS; LANDFILL GAS, LANDFILL CONDENSATE, AND LEACHATE PIPELINES; SURFACE CONTROL PIPES; ETC. COORDINATION WITH LOCAL UTILITIES AND/OR A PRIVATE UTILITY LOCATION SERVICE MAY BE REQUIRED.  
  
LOCATION OF EXISTING UTILITIES SHALL BE CLEARLY MARKED BY FLAGGED 4-FT HIGH WOODEN STAKES AT 100-FT INTERVALS AND PAINT ON THE GROUND SURFACE. NEARER INTERVALS MAY BE REQUIRED BASED ON FIELD CONDITIONS. CONTRACTOR SHALL MONITOR AND MAINTAIN THE MARKINGS DURING THE CONSTRUCTION PROJECT UNTIL FINAL ACCEPTANCE OF THE WORK BY THE OWNER/OPERATOR.
- CONTRACTOR SHALL FOLLOW ALL APPLICABLE CITY, STATE AND FEDERAL HEALTH AND SAFETY REQUIREMENTS TO GUARD AND PROTECT ALL WORKERS, PEDESTRIANS, AND THE PUBLIC FROM EXCAVATIONS, BLASTING OPERATIONS, CONSTRUCTION EQUIPMENT, TRAFFIC, CONSTRUCTION OPERATIONS, ALL OBSTRUCTIONS, AND OTHER DANGEROUS ITEMS (E.G., LANDFILL GAS) OR AREAS. A HEALTH AND SAFETY PLAN IS REQUIRED AS PART OF THE WORK.

LEGEND

- EXISTING GROUND 10-FT CONTOUR (MSL)
- EXISTING GROUND 2-FT CONTOUR (MSL)
- EXISTING BENCHMARK
- PROPERTY LINE
- CELLS E5, E6, AND E7 LIMIT OF EARTHWORK
- CELL E8 APPROXIMATE LIMIT OF EARTHWORK
- WESTERN SURFACE WATER DRAINAGE APPROXIMATE LIMIT OF EARTHWORK (SEE NOTE 2)
- PROPOSED STOCKPILE BOUNDARY



REVISIONS			
NO.	DESCRIPTION	DATE	BY




Geosyntec  
consultants

475 14th Street  
Suite 400  
Oakland, CA 94612

SITE PLAN AND  
EXISTING TOPOGRAPHY  
CELLS E5 THROUGH E8  
WAIMANALO GULCH LANDFILL  
EWA BEACH, OAHU, HAWAII

CONSTRUCTION DRAWINGS			
DES BY: ACP	DATE: JANUARY 2010	SHEET NO.  2	
DRN BY: ACP	SCALE: AS SHOWN		
CHK BY: FWS	PROJECT: WL0770		
REV BY: HDS	DOCUMENT:		
APP BY: HDS	FILE:		



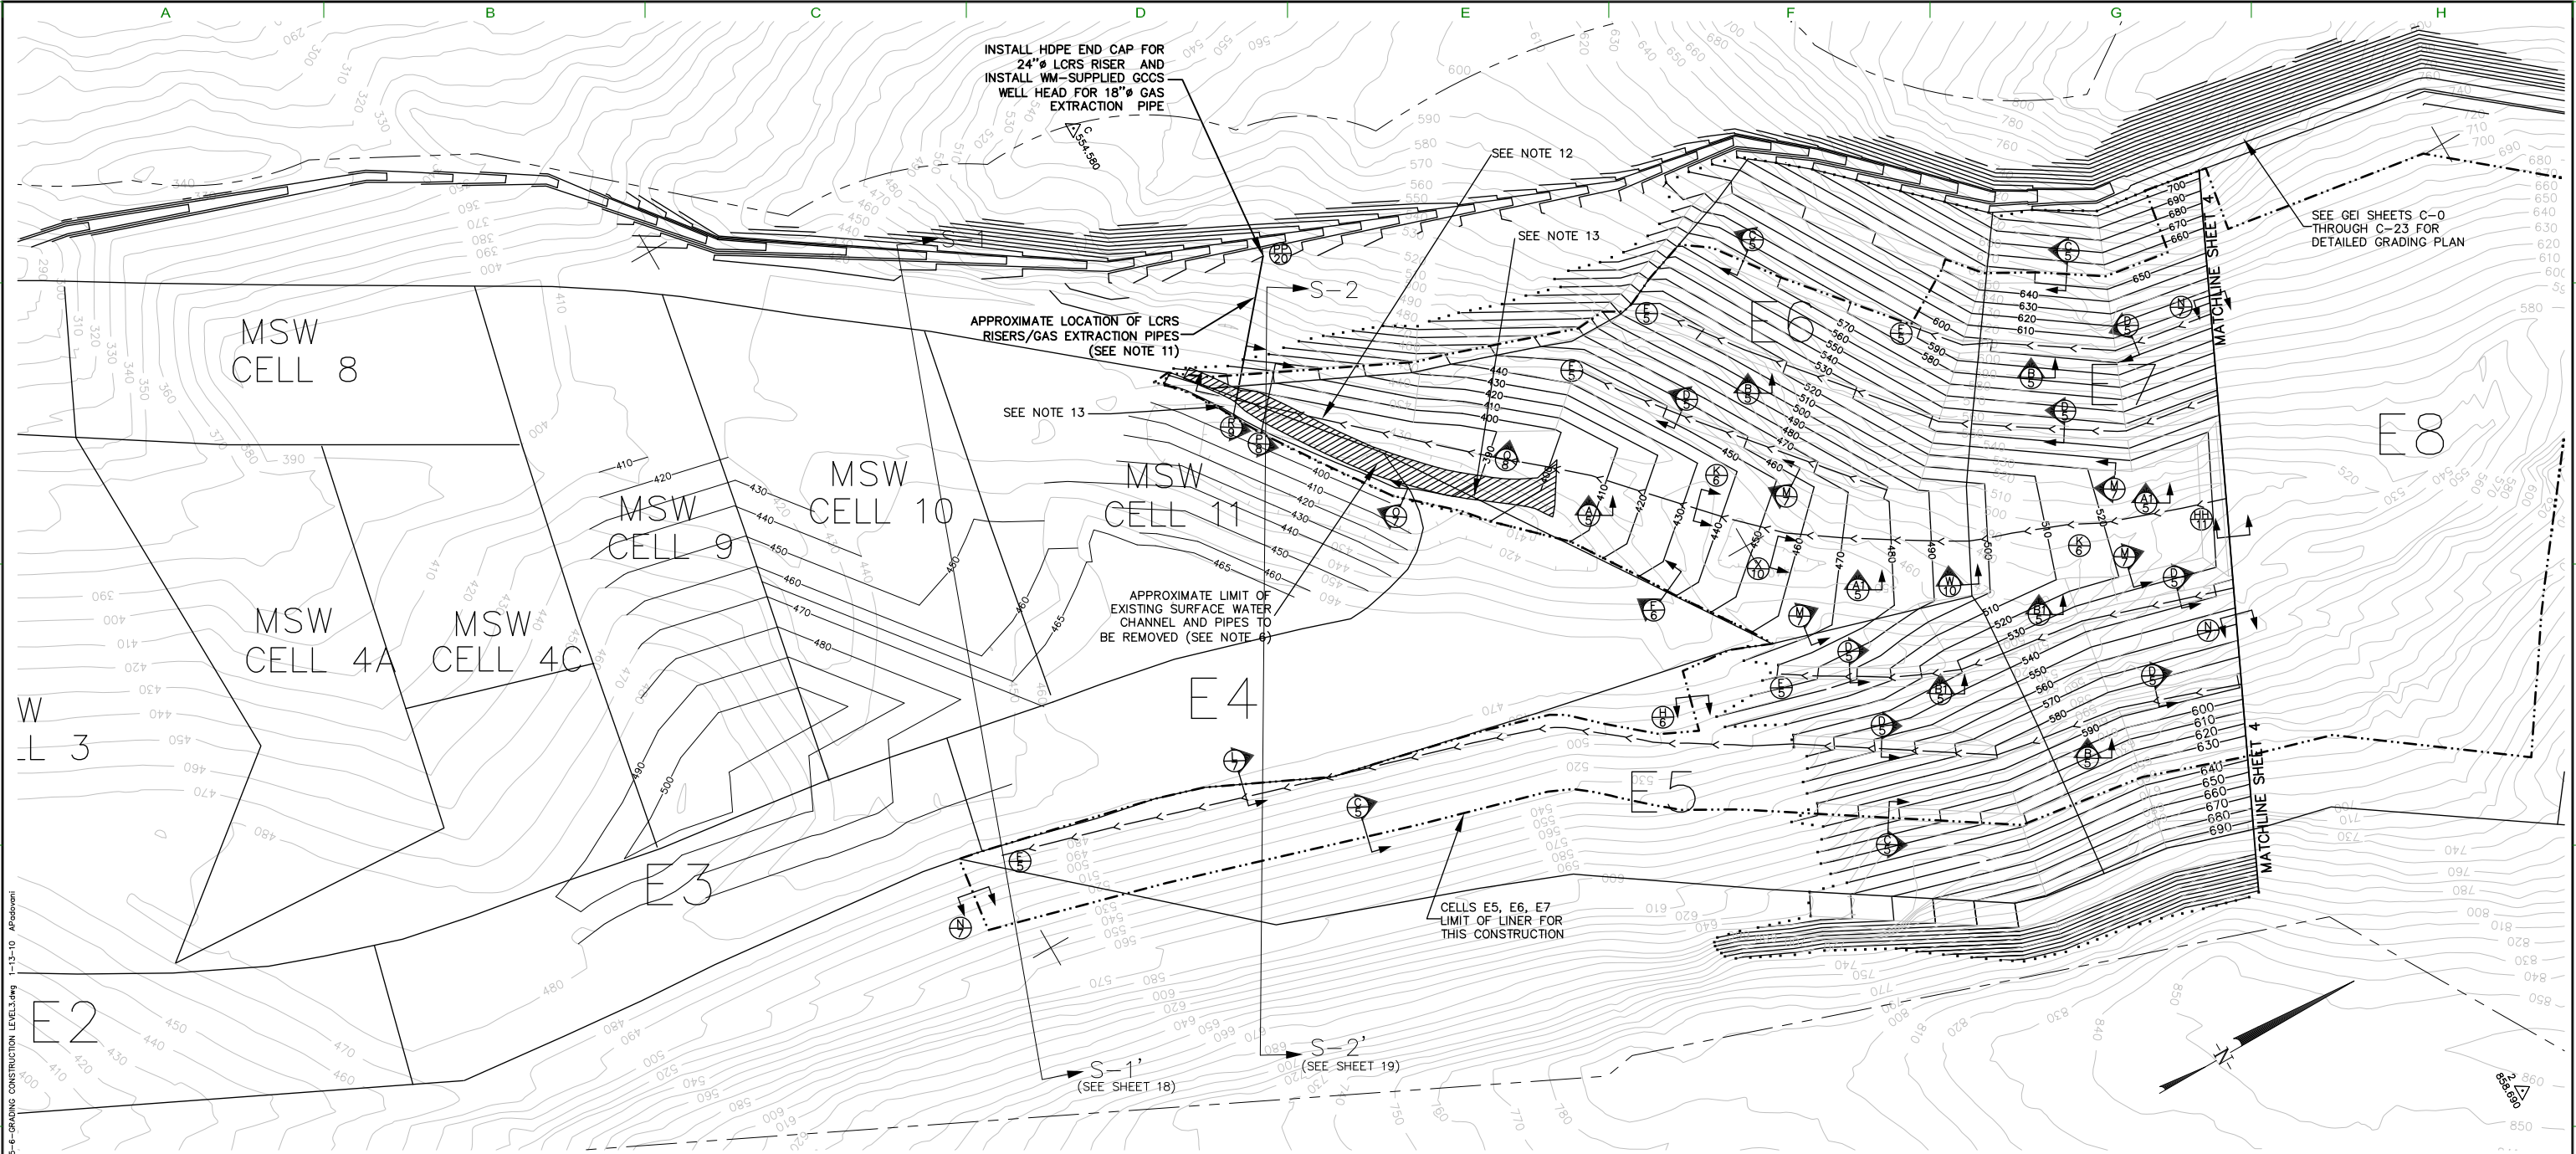

NOTES:

- EXISTING TOPOGRAPHY BASED ON 16 MARCH 2009 AERIAL SURVEY PROVIDED BY OWNER. WASTE ELEVATIONS MAY VARY.
- THE LOCATION OF TIE-IN TO EXISTING LINER SHOWN IS APPROXIMATE. ACTUAL LOCATION OF TIE-IN SHOULD BE FIELD VERIFIED PRIOR TO CONSTRUCTION AND MAY VARY FROM LAYOUT SHOWN. CONTRACTOR TO FIELD LOCATE AND UNCOVER EXISTING LINER SYSTEM TERMINATION, AND EXTEND AND CONNECT NEW LINER SYSTEM COMPONENTS TO EXISTING AS NECESSARY TO MAINTAIN LINER SYSTEM CONTINUITY.
- GRADES ALONG TIE-IN MAY BE ADJUSTED AS NEEDED TO MATCH EXISTING SUBGRADE CONDITIONS WITH APPROVAL BY THE ENGINEER.
- FOR VEHICULAR TRAFFIC ON LINER SYSTEM, MINIMUM ALLOWABLE GROUND PRESSURES AND COVER MATERIAL REQUIREMENTS IN THE SPECIFICATIONS TO BE FOLLOWED AT ALL TIMES DURING AND AFTER CONSTRUCTION.
- BEFORE, DURING, AND AFTER STORM EVENTS, CONTRACTOR TO CONTROL AND DIRECT SURFACE WATER RUNOFF BY PUMPING OR OTHER METHODS. CONTRACTOR TO COORDINATE WITH OWNER FOR EROSION CONTROL METHODS.
- EXISTING CONCRETE CHANNEL (INCLUDING WINGWALLS AND HEADWALL) AND EXISTING 48" Ø PIPES TO BE REMOVED WITHIN THIS AREA, PRIOR TO SUBGRADE PREPARATION OF CELL E6.
- BENCHES THAT WILL NOT RECEIVE LINER SHALL BE LOCALLY GRADED SO THAT WATER FLOWS AWAY FROM LANDFILL.
- IF COLLUVIUM OR ALLUVIUM ARE ENCOUNTERED DURING EXCAVATION, SLOPES SHALL BE RE-EVALUATED AND MAY NEED TO BE FLATTENED.
- A SUBDRAIN PIPE MAY BE REQUIRED TO COLLECT SEEPS. SEEPS TO BE IDENTIFIED BY A GEOLOGIST. SUBDRAIN PIPE MAY NEED TO BE EXTENDED PAST THE LIMITS CURRENTLY SHOWN.
- CONTRACTOR SHALL ALLOW A GEOLOGIST TO ACCESS THE EXCAVATED SLOPES FOR GEOLOGIC MAPPING AND TO CONFIRM THAT THE SLOPES WILL BE STABLE.

NOTES (CONT.):

- RISER PIPES SHALL BE EXTENDED AS WEST BERM IS CONSTRUCTED.
- AREA OF INCREASED GRAVEL THICKNESS SHOWN ON SHEET 4.
- EXCAVATION FOR SUMP AREA AND ITS VICINITY WILL REQUIRE SPECIAL PROVISIONS; THEREFORE COORDINATION WITH OWNER/OPERATOR WILL BE REQUIRED.**
- A MINIMUM OF THREE DAYS BEFORE STARTING CONSTRUCTION AND AS PART OF MOBILIZATION, CONTRACTOR WITH OWNER/OPERATOR SHALL CLEARLY MARK/IDENTIFY THE LOCATION OF EXISTING UTILITIES AND/OR FACILITIES. EXISTING UTILITIES MAY BE OVERHEAD, ABOVE-GROUND, OR BURIED. EXISTING UTILITIES INCLUDE, BUT ARE NOT LIMITED TO, OVERHEAD POWER LINES AND EXISTING FOUNDATIONS; GROUNDWATER MONITORING WELLS; LANDFILL GAS PROBES; LANDFILL GAS WELLS; SURFACE WATER SAMPLING LOCATIONS; LANDFILL GAS, LANDFILL CONDENSATE, AND LEACHATE PIPELINES; SURFACE CONTROL PIPES; ETC. COORDINATION WITH LOCAL UTILITIES AND/OR A PRIVATE UTILITY LOCATION SERVICE MAY BE REQUIRED.
- LOCATION OF EXISTING UTILITIES SHALL BE CLEARLY MARKED BY FLAGGED 4-FT HIGH WOODEN STAKES AT 100-FT INTERVALS AND PAINT ON THE GROUND SURFACE. NEARER INTERVALS MAY BE REQUIRED BASED ON FIELD CONDITIONS. CONTRACTOR SHALL MONITOR AND MAINTAIN THE MARKINGS DURING THE CONSTRUCTION PROJECT UNTIL FINAL ACCEPTANCE OF THE WORK BY THE OWNER/OPERATOR.
- CONTRACTOR SHALL FOLLOW ALL APPLICABLE CITY, STATE AND FEDERAL HEALTH AND SAFETY REQUIREMENTS TO GUARD AND PROTECT ALL WORKERS, PEDESTRIANS, AND THE PUBLIC FROM EXCAVATIONS, BLASTING OPERATIONS, CONSTRUCTION EQUIPMENT, TRAFFIC, CONSTRUCTION OPERATIONS, ALL OBSTRUCTIONS, AND OTHER DANGEROUS ITEMS (E.G., LANDFILL GAS) OR AREAS. A HEALTH AND SAFETY PLAN IS REQUIRED AS PART OF THE WORK.
- LINER LIMITS SHOWN ARE EXPECTED TO BE CONSTRUCTED BETWEEN 2010 AND 2014.
- LIMIT OF FUTURE WASTE FILL IN CELLS E5 THROUGH E8 MAY CHANGE DEPENDING ON FUTURE WASTE STREAM.

LEGEND

- 480 CELLS E5 THROUGH E7 BASE GRADE 10-FT CONTOUR (MSL)
- 800 EXISTING GROUND 10-FT CONTOUR (MSL)
- 500 CELL E4 WASTE GRADES 10-FT CONTOUR (MSL)
- 288.16 EXISTING BENCHMARK
- CELL BOUNDARY/LIMIT OF FUTURE WASTE FILL (NOTE 17)
- PROPERTY LINE
- APPROXIMATE LIMIT OF EARTHWORK
- LCRS PIPING
- APPROXIMATE CELLS E5 THROUGH E8 LINER LIMIT (NOTE 16)
- CROSS SECTION LINE



REVISIONS			
NO.	DESCRIPTION	DATE	BY



Geosyntec  
consultants

475 14th Street  
Suite 400  
Oakland, CA 94612

BASE GRADING PLAN AND LCRS  
LAYOUT IN CELLS E5-E7

CELLS E5 THROUGH E8  
WAIMANALO GULCH LANDFILL  
EWA BEACH, OAHU, HAWAII


CONSTRUCTION DRAWINGS

DES BY: ACP	DATE: JANUARY 2010
DRN BY: ACP	SCALE: AS SHOWN
CHK BY: FWS	PROJECT: WL0770
REV BY: HDS	DOCUMENT:
APP BY: HDS	FILE:

SHEET NO.

3



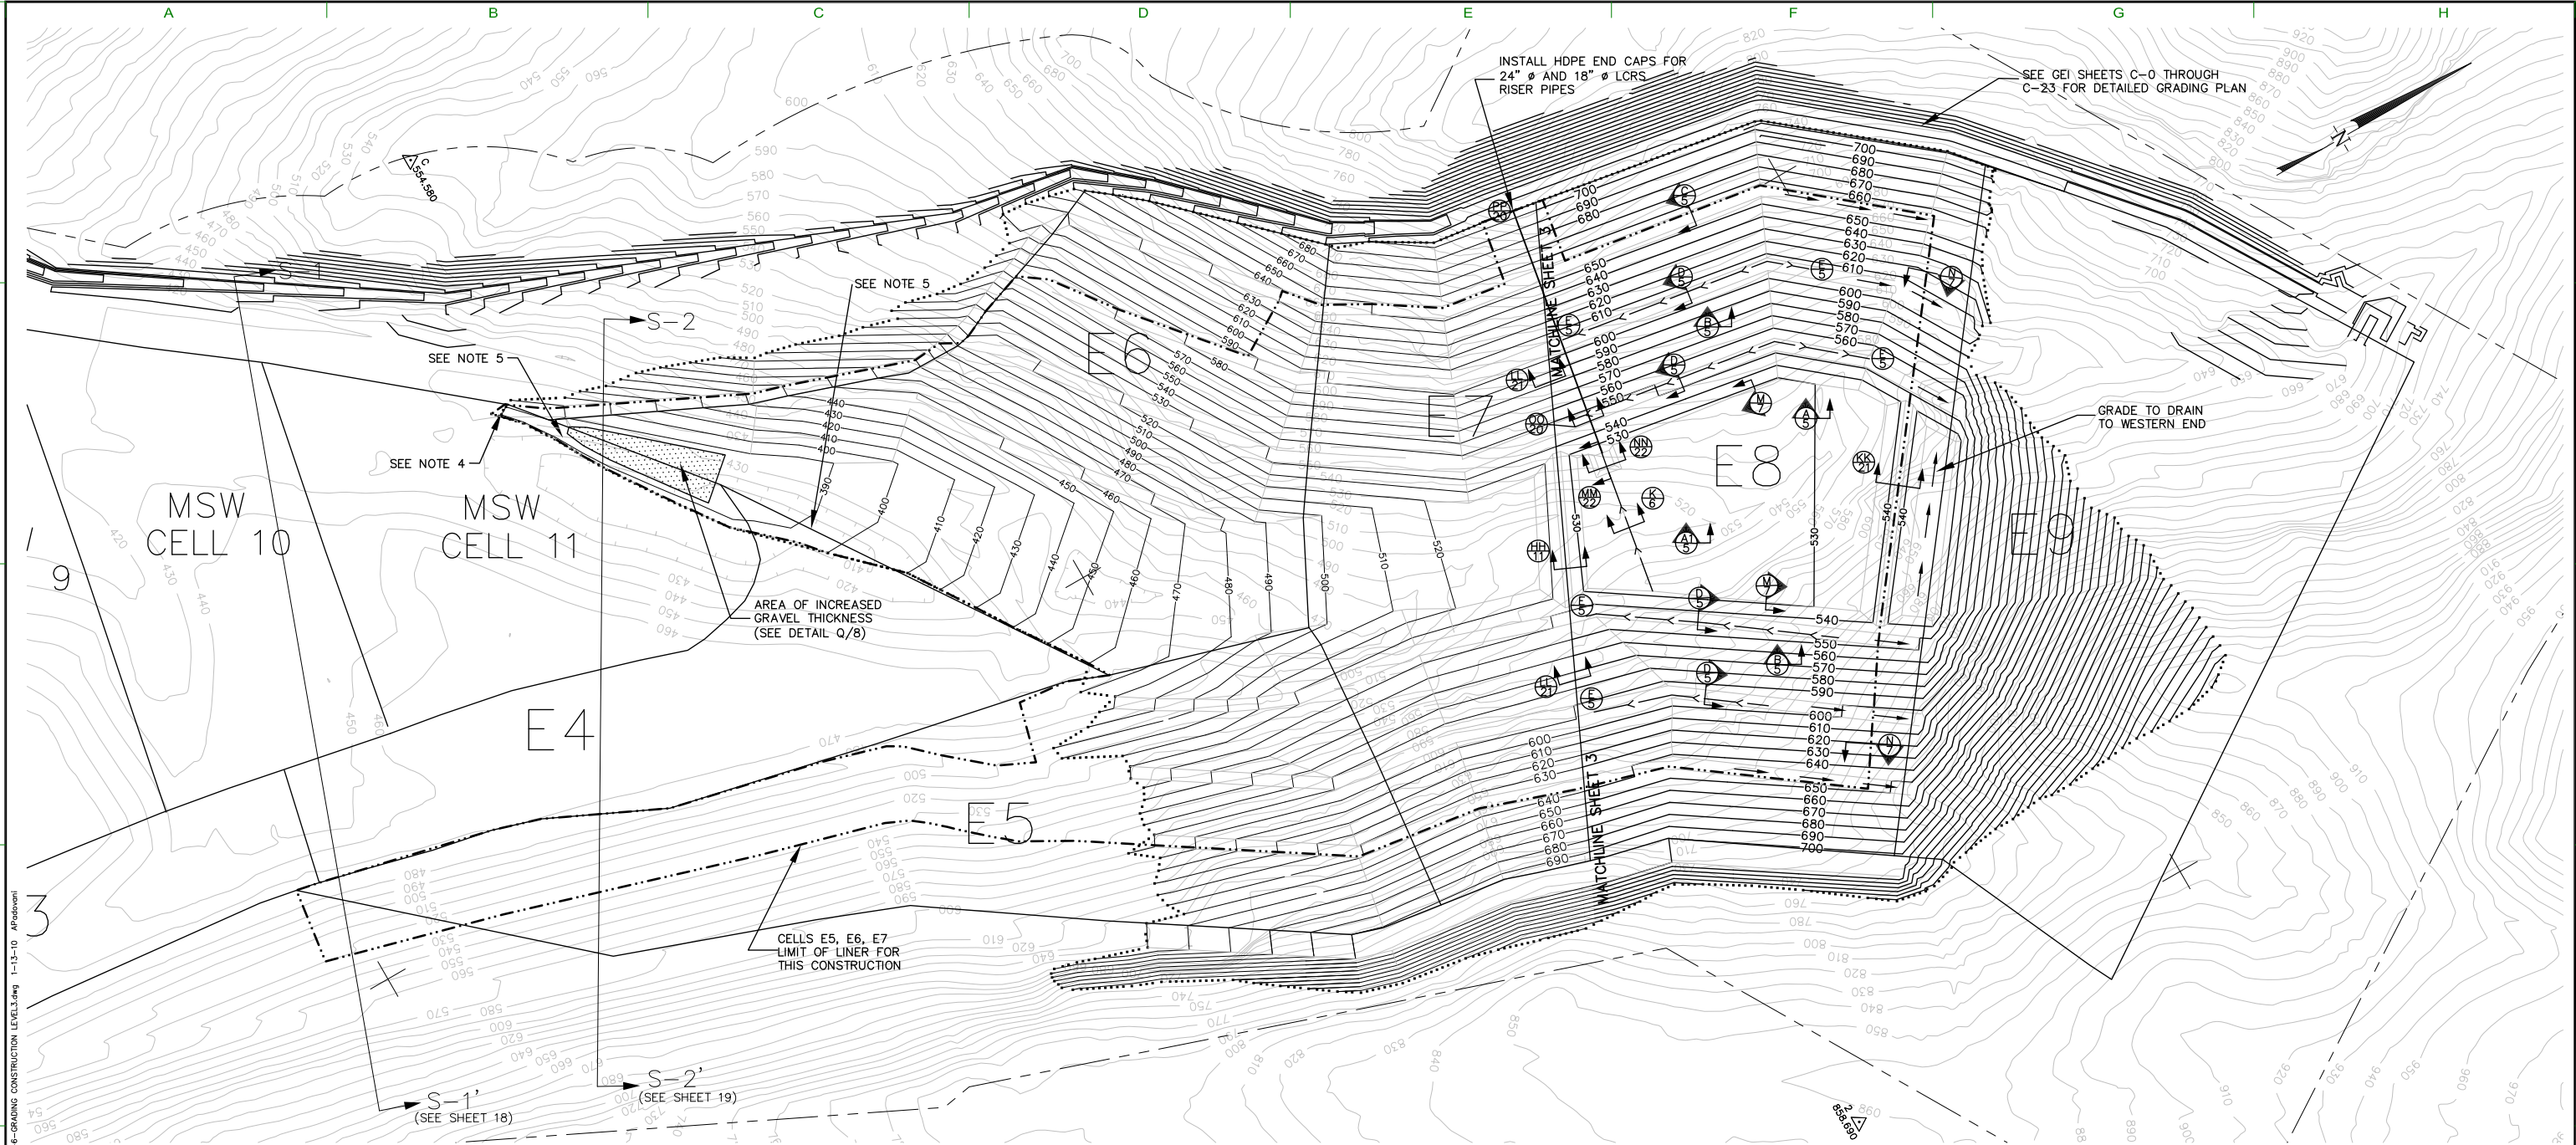


NOTES:

1. EXISTING TOPOGRAPHY BASED ON 16 MARCH 2009 AERIAL SURVEY PROVIDED BY OWNER. WASTE ELEVATIONS MAY VARY.
2. BEFORE, DURING, AND AFTER STORM EVENTS, CONTRACTOR TO CONTROL AND DIRECT SURFACE WATER RUNOFF BY PUMPING OR OTHER METHODS. CONTRACTOR TO COORDINATE WITH OWNER FOR EROSION CONTROL METHODS.
3. SLOPES SHALL BE EXCAVATED FROM TOP DOWN. CONTRACTOR SHALL ALLOW A GEOLOGIST TO ACCESS THE EXCAVATED SLOPES FOR GEOLOGIC MAPPING AND TO CONFIRM THAT THE SLOPES WILL BE STABLE.
4. THE LOCATION OF THE 36-INCH HDPE PIPE SHOWN IN THE AREAS OF CELLS E5 AND E6 MAY NEED TO BE FIELD-ADJUSTED DURING CONSTRUCTION BASED ON THE ACTUAL LOCATION OF THE 48-INCH CMP IN THE E6 SUMP AREA. CONTRACTOR SHALL SUBMIT/CONFIRM FINAL LOCATION LAYOUT OF 36-INCH HDPE PIPE FOR THE ENGINEER.
5. EXCAVATION FOR SUMP AREA AND ITS VICINITY WILL REQUIRE SPECIAL PROVISIONS; THEREFORE COORDINATION WITH OWNER/OPERATOR WILL BE REQUIRED.
6. A MINIMUM OF THREE DAYS BEFORE STARTING CONSTRUCTION AND AS PART OF MOBILIZATION, CONTRACTOR WITH OWNER/OPERATOR SHALL CLEARLY MARK/IDENTIFY THE LOCATION OF EXISTING UTILITIES AND/OR FACILITIES. EXISTING UTILITIES MAY BE OVERHEAD, ABOVE-GROUND, OR BURIED. EXISTING UTILITIES INCLUDE, BUT ARE NOT LIMITED TO, OVERHEAD POWER LINES AND EXISTING FOUNDATIONS; GROUNDWATER MONITORING WELLS; LANDFILL GAS PROBES; LANDFILL GAS WELLS; SURFACE WATER SAMPLING LOCATIONS; LANDFILL GAS, LANDFILL CONDENSATE, AND LEACHATE PIPELINES; SURFACE CONTROL PIPES; ETC. COORDINATION WITH LOCAL UTILITIES AND/OR A PRIVATE UTILITY LOCATION SERVICE MAY BE REQUIRED.

LOCATION OF EXISTING UTILITIES SHALL BE CLEARLY MARKED BY FLAGGED 4-FT HIGH WOODEN STAKES AT 100-FT INTERVALS AND PAINT

NOTES (CONT.):

- ON THE GROUND SURFACE. NEARER INTERVALS MAY BE REQUIRED BASED ON FIELD CONDITIONS. CONTRACTOR SHALL MONITOR AND MAINTAIN THE MARKINGS DURING THE CONSTRUCTION PROJECT UNTIL FINAL ACCEPTANCE OF THE WORK BY THE OWNER/OPERATOR.
7. CONTRACTOR SHALL FOLLOW ALL APPLICABLE CITY, STATE AND FEDERAL HEALTH AND SAFETY REQUIREMENTS TO GUARD AND PROTECT ALL WORKERS, PEDESTRIANS, AND THE PUBLIC FROM EXCAVATIONS, BLASTING OPERATIONS, CONSTRUCTION EQUIPMENT, TRAFFIC, CONSTRUCTION OPERATIONS, ALL OBSTRUCTIONS, AND OTHER DANGEROUS ITEMS (E.G., LANDFILL GAS) OR AREAS. A HEALTH AND SAFETY PLAN IS REQUIRED AS PART OF THE WORK.
  8. LINER LIMITS SHOWN HERE ARE EXPECTED TO BE CONSTRUCTED BETWEEN 2010 AND 2014.
  9. CONTRACTOR TO GRADE SLOPE/BENCH TO DRAIN IN FLOW DIRECTION AS SHOWN. REFER TO GEI SHEETS C-0 THROUGH C-23 FOR DITCH GRADING.
  10. LIMIT OF FUTURE WASTE FILL IN CELLS E5 THROUGH E8 MAY CHANGE DEPENDING ON FUTURE WASTE STREAM.

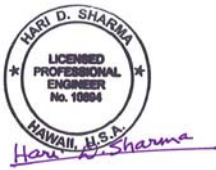

LEGEND

- 530 CELL E8 BASE GRADE 10-FT CONTOUR (MSL)
- 800 EXISTING GROUND 10-FT CONTOUR (MSL)
- 800 EXISTING CELLS E5 THROUGH E7 BASE GRADES 10-FT CONTOUR (MSL)
- 288.16 EXISTING BENCHMARK
- CELL BOUNDARY/LIMIT OF FUTURE WASTE FILL (NOTE 10)
- PROPERTY LINE
- APPROXIMATE LIMIT OF EARTHWORK
- LORS PIPING
- APPROXIMATE CELLS E5 THROUGH E8 LINER LIMIT (NOTE 8)
- FLOW DIRECTION (SEE NOTE 9)
- CROSS SECTION LINE



REVISIONS			
NO.	DESCRIPTION	DATE	BY



Geosyntec  
consultants



475 14th Street  
Suite 400  
Oakland, CA 94612

BASE GRADING PLAN  
CELLS E8  
CELLS E5 THROUGH E8  
WAIMANALO GULCH LANDFILL  
EWA BEACH, OAHU, HAWAII

CONSTRUCTION DRAWINGS	
DES BY: ACP	DATE: JANUARY 2010
DRN BY: ACP	SCALE: AS SHOWN
CHK BY: FWS	PROJECT: WL0770
REV BY: HDS	DOCUMENT:
APP BY: HDS	FILE:

SHEET NO.  
4



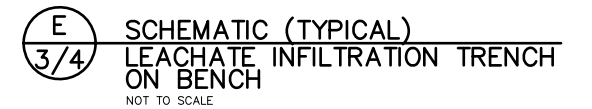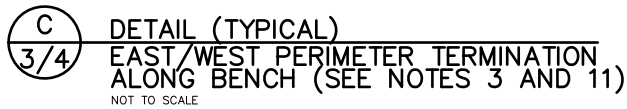

REVISIONS			
NO.	DESCRIPTION	DATE	BY



Geosyntec<sup>®</sup>  
consultants

**475 14th Street  
Suite 400  
Oakland, CA 94612**

## CONTAINMENT SYSTEM DETAILS I

CELLS E5 THROUGH E8  
WAIMANALO GULCH LANDFILL  
EWA BEACH, OAHU, HAWAII

CONSTRUCTION DRAWINGS





DES BY: ACP	DATE: JANUARY 2010
DRN BY: ACP	SCALE: AS SHOWN
CHK BY: FWS	PROJECT: WL0770
REV BY: HDS	DOCUMENT:
APP BY: HDS	
FILE:	

SHEET NO.

5





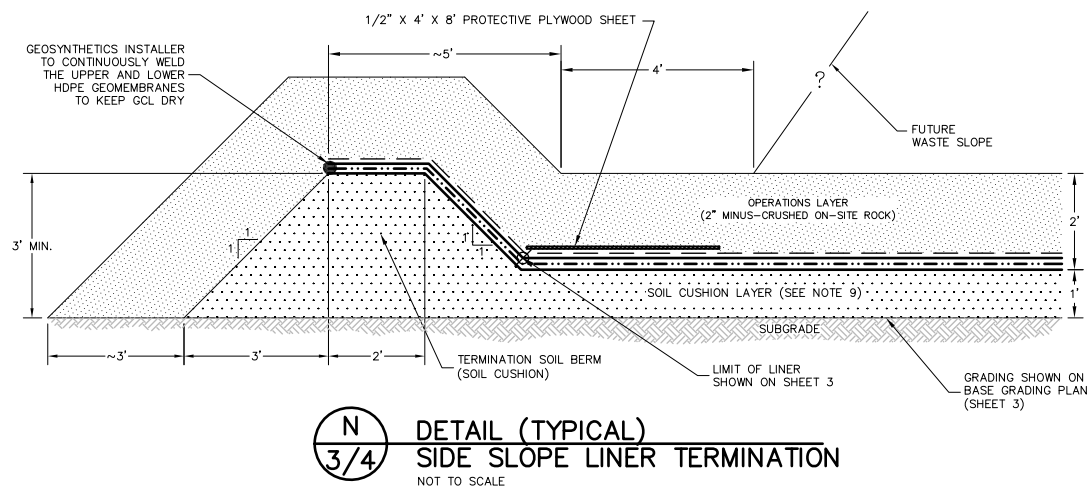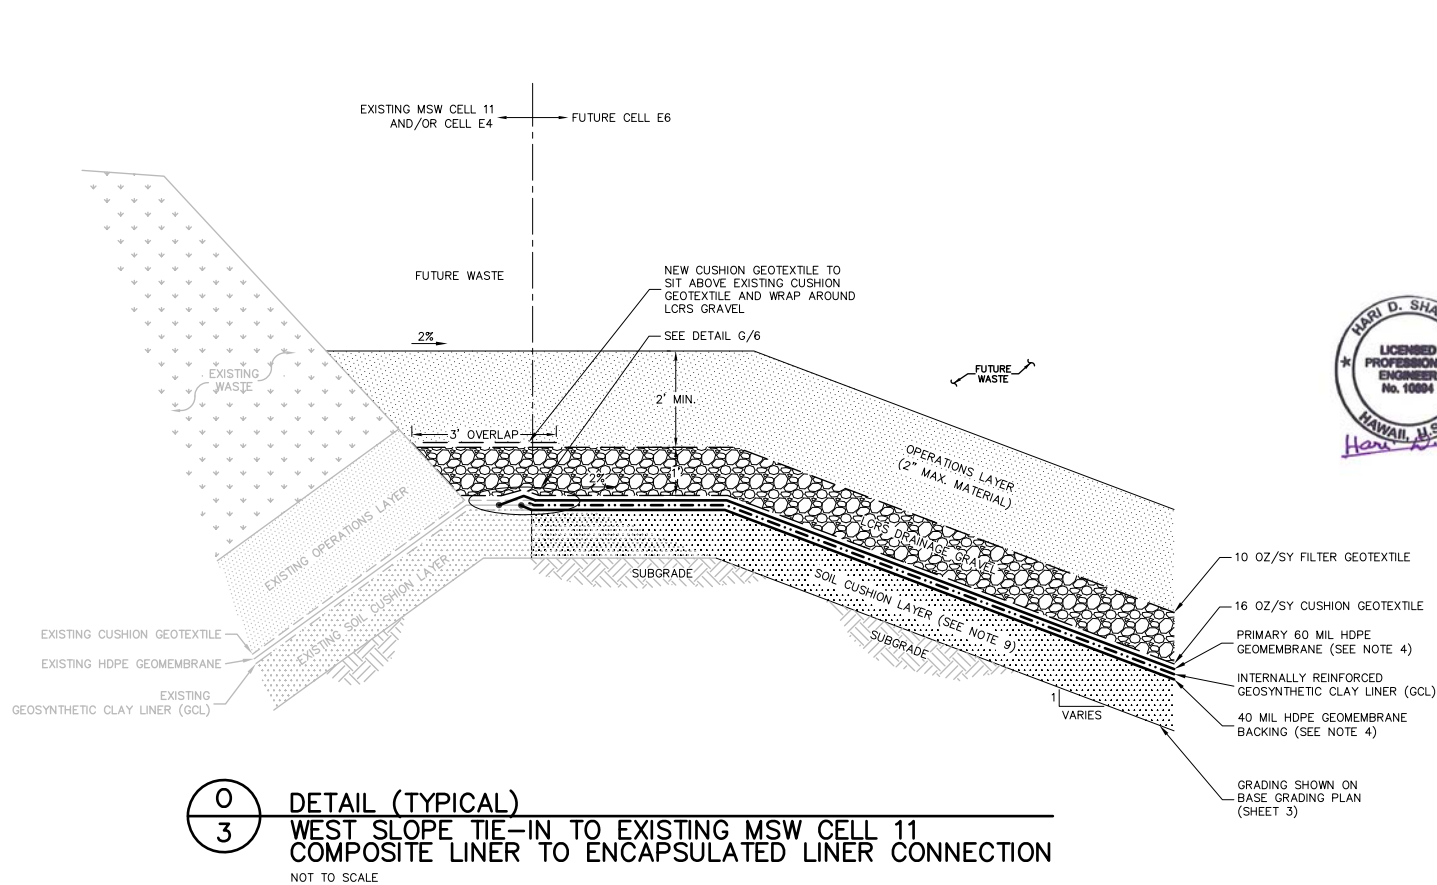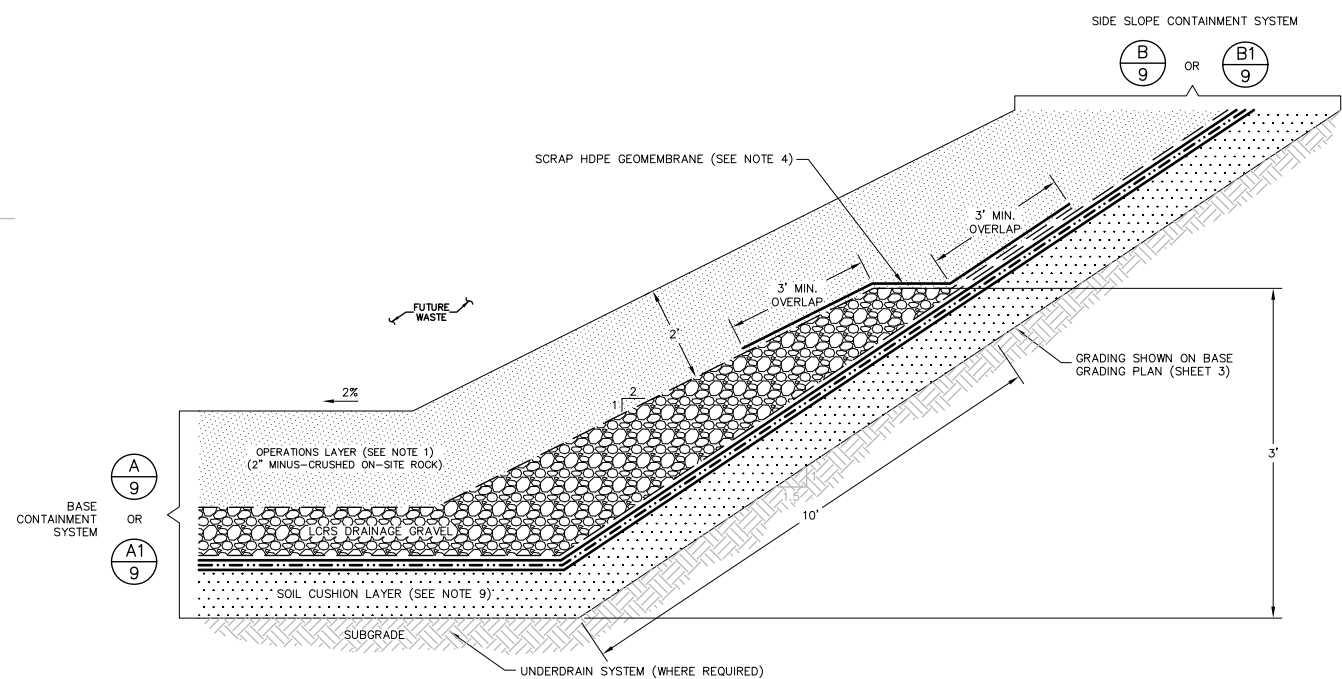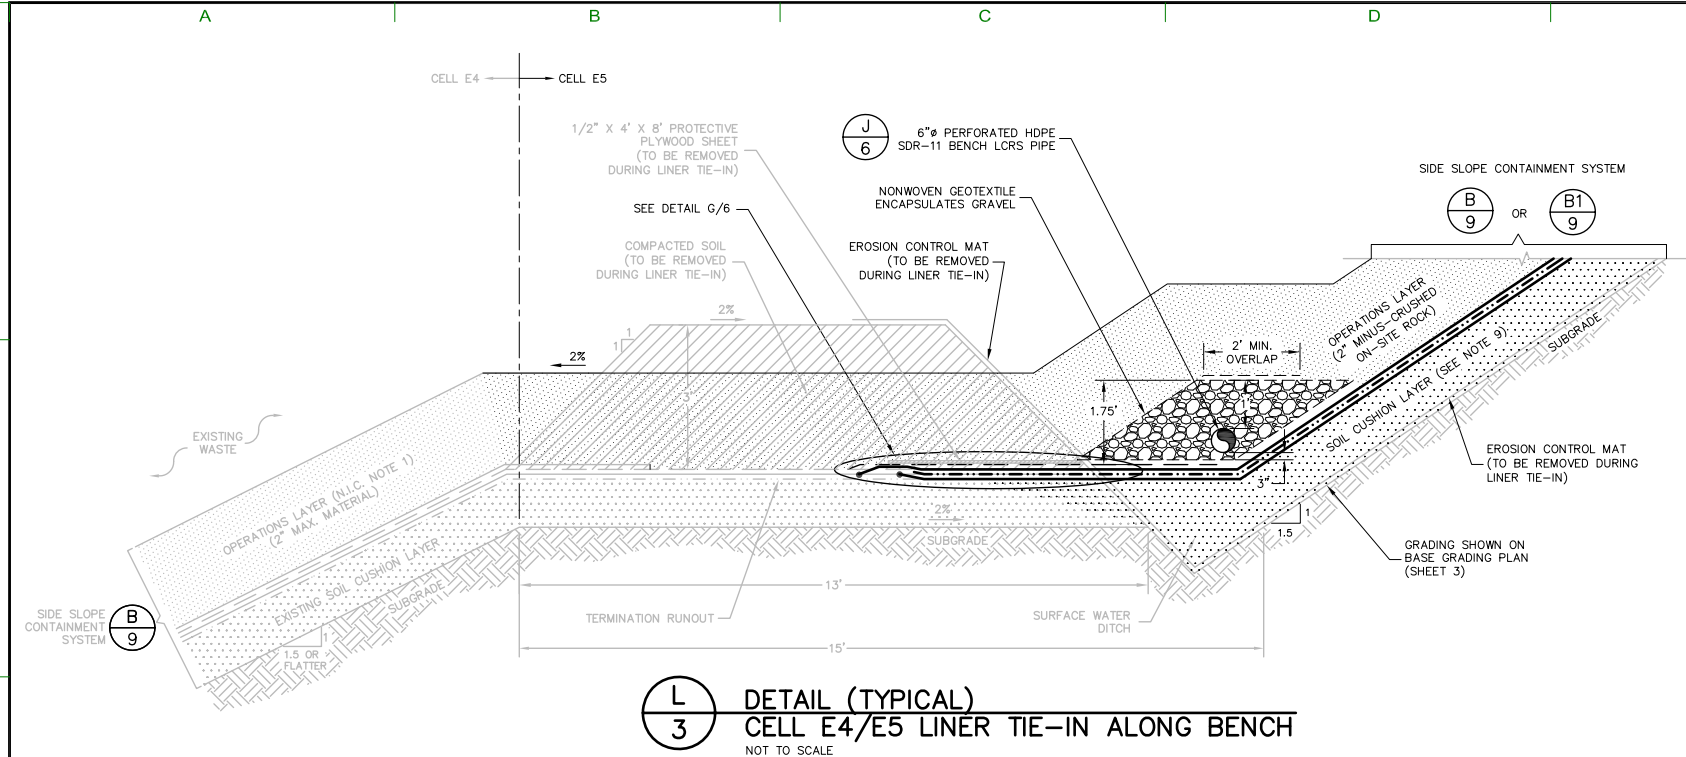

- NOTES:
- CONTRACTOR TO PLACE OPERATIONS LAYER ON FLOOR, BENCHES AND 10 FEET ALONG THE SIDE SLOPE LENGTH ABOVE THE FLOOR OR BENCH. OWNER TO PLACE OPERATIONS LAYER SOIL ON SIDE SLOPE BEYOND THE 10-FT REQUIREMENT IN THIS CONTRACT IN COORDINATION WITH WASTE PLACEMENT. OPERATIONS LAYER SHALL MEET REQUIREMENTS FOR PERMEABILITY AND GRADATION IN THE SPECIFICATIONS. THE MAXIMUM OPERATING WEIGHT OF THE EQUIPMENT USED BY THE CONTRACTOR (DURING CONSTRUCTION) AND BY THE OWNER (DURING OPERATIONS) TO PLACE OPERATIONS LAYER SHALL BE A CATERPILLAR D3C LGP OR EQUIVALENT. NO BRAKING IS ALLOWED WHEN PLACING OPERATIONS LAYER SOIL ALONG THE SIDESLOPES.
  - INSTALLER TO PROVIDE SANDBAGS AND OTHER METHODS TO PROTECT THE EXPOSED GEOSYNTHETICS FROM WIND UPLIFT AND SHALL SUBMIT THEIR PLAN FOR APPROVAL BY OPERATOR.
  - TERMINATION OF GEOSYNTHETICS SHOWN ON DRAWINGS ARE FOR POST-CONSTRUCTION ANCHOR TRENCH LOADS. INSTALLER/CONTRACTOR ARE RESPONSIBLE FOR MAINTAINING ANCHORAGE OF GEOSYNTHETICS DURING CONSTRUCTION UNTIL OWNER ACCEPTS THE WORK. AFTER CONSTRUCTION, OWNER IS RESPONSIBLE FOR ANCHORAGE UNTIL HDPE GEOMEMBRANE IS OVERLAIN BY PROTECTIVE OPERATIONS LAYER AS PART OF LANDFILLING OPERATIONS (SEE NOTES 1 AND 5).
  - FOR ALL CELLS, GEOMEMBRANE SHALL BE TEXTURED ON BOTH SIDES.
  - CONTRACTOR, WITH PRIOR APPROVAL FROM OWNER, TO DEPLOY SACRIFICIAL GEOMEMBRANE IN AREAS WHERE GEOTEXTILE CUSHION WILL BE EXPOSED FOR MORE THAN 60 DAYS. OWNER TO REMOVE SACRIFICIAL GEOMEMBRANE BEFORE PLACING OPERATIONS LAYER. SACRIFICIAL GEOSYNTHETICS, IF DEPLOYED, SHALL BE REMOVED BY THE OWNER DURING OPERATIONS.
  - SCREENED BACK FEATURES CORRESPOND TO EXISTING OR FUTURE LAYERS.
  - CONTRACTOR TO FIELD LOCATE AND UNCOVER EXISTING LINER SYSTEM TERMINATION. EXTEND AND CONNECT NEW CONTAINMENT SYSTEM TO EXISTING CONTAINMENT SYSTEM AS NECESSARY TO MAINTAIN A CONTINUOUS CONTAINMENT SYSTEM; I.E., (A) WELD NEW GEOMEMBRANE TO EXISTING GEOMEMBRANE; (B) THE WELD SHALL BE A MINIMUM 4 FT AWAY FROM THE EDGE OF THE SLOPE; (C) OVERLAP THE NEW GCL A MINIMUM OF 2 FT OVER THE EXISTING GCL; AND (D) THE GEOTEXTILE SHALL BE SEWN. ALL WELDING, OVERLAPPING, AND SEWING SHALL BE DONE IN ACCORDANCE WITH THE SPECIFICATIONS.
  - INSTALLER TO STAGE DEPLOYMENT OF GEOSYNTHETICS SO THAT EQUIPMENT DOES NOT NEED TO DRIVE DIRECTLY OVER ALREADY DEPLOYED GEOSYNTHETIC CLAY LINER (GCL) OR GEOMEMBRANE. ALLOWED GROUND PRESSURES OVER GEOSYNTHETICS ARE PROVIDED IN THE SPECIFICATIONS AND MUST BE FOLLOWED AT ALL TIMES DURING AND AFTER CONSTRUCTION. CONTRACTOR TO STAGE AND COORDINATE PLACEMENT OF DRAINAGE GRAVEL AND OPERATIONS LAYER SO THAT GCL, GEOMEMBRANE, AND GEOTEXTILES ARE NOT DRIVEN OVER UNLESS MATERIAL THICKNESSES LISTED IN THE SPECIFICATIONS ARE MET.
  - IF SOIL CUSHION LAYER CAN NOT BE PLACED ON THE SIDE SLOPES, THEN THE SUBGRADE SHALL RECEIVE GUNITE HAVING SURFACE PROJECTIONS LESS THAN 0.25 INCH TO RECEIVE GEOSYNTHETICS.

P:\CADD\Land Projects\3\WMA\WMA\Drawings\Cell E5-E8 and Partial West Berm Construction\Cell E5-E8 DETAILS CONSTRUCTION LEVEL\REV.dwg 1-13-10 CHW

REVISIONS			
NO.	DESCRIPTION	DATE	BY





Geosyntec  
consultants

475 14th Street  
Suite 400  
Oakland, CA 94612

CONTAINMENT SYSTEM  
DETAILS III  
CELLS E5 THROUGH E8  
WAIMANALO GULCH LANDFILL  
EWA BEACH, OAHU, HAWAII

CONSTRUCTION DRAWINGS	
DES BY: ACP	DATE: JANUARY 2010
DRN BY: ACP	SCALE: AS SHOWN
CHK BY: FWS	PROJECT: WL0770
REV BY: HDS	DOCUMENT:
APP BY: HDS	FILE:

SHEET NO.  
7

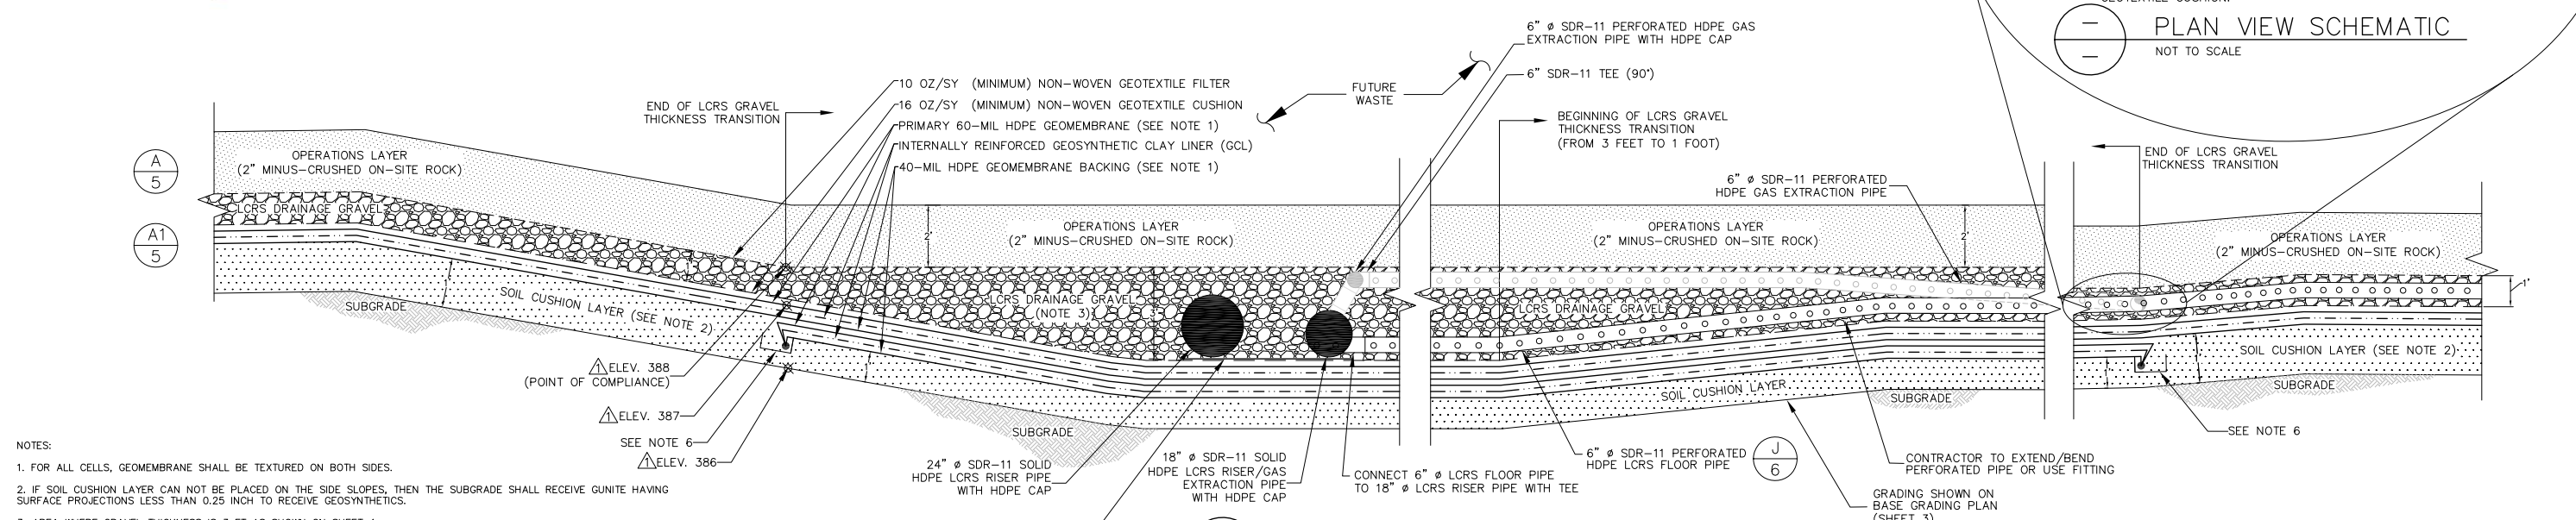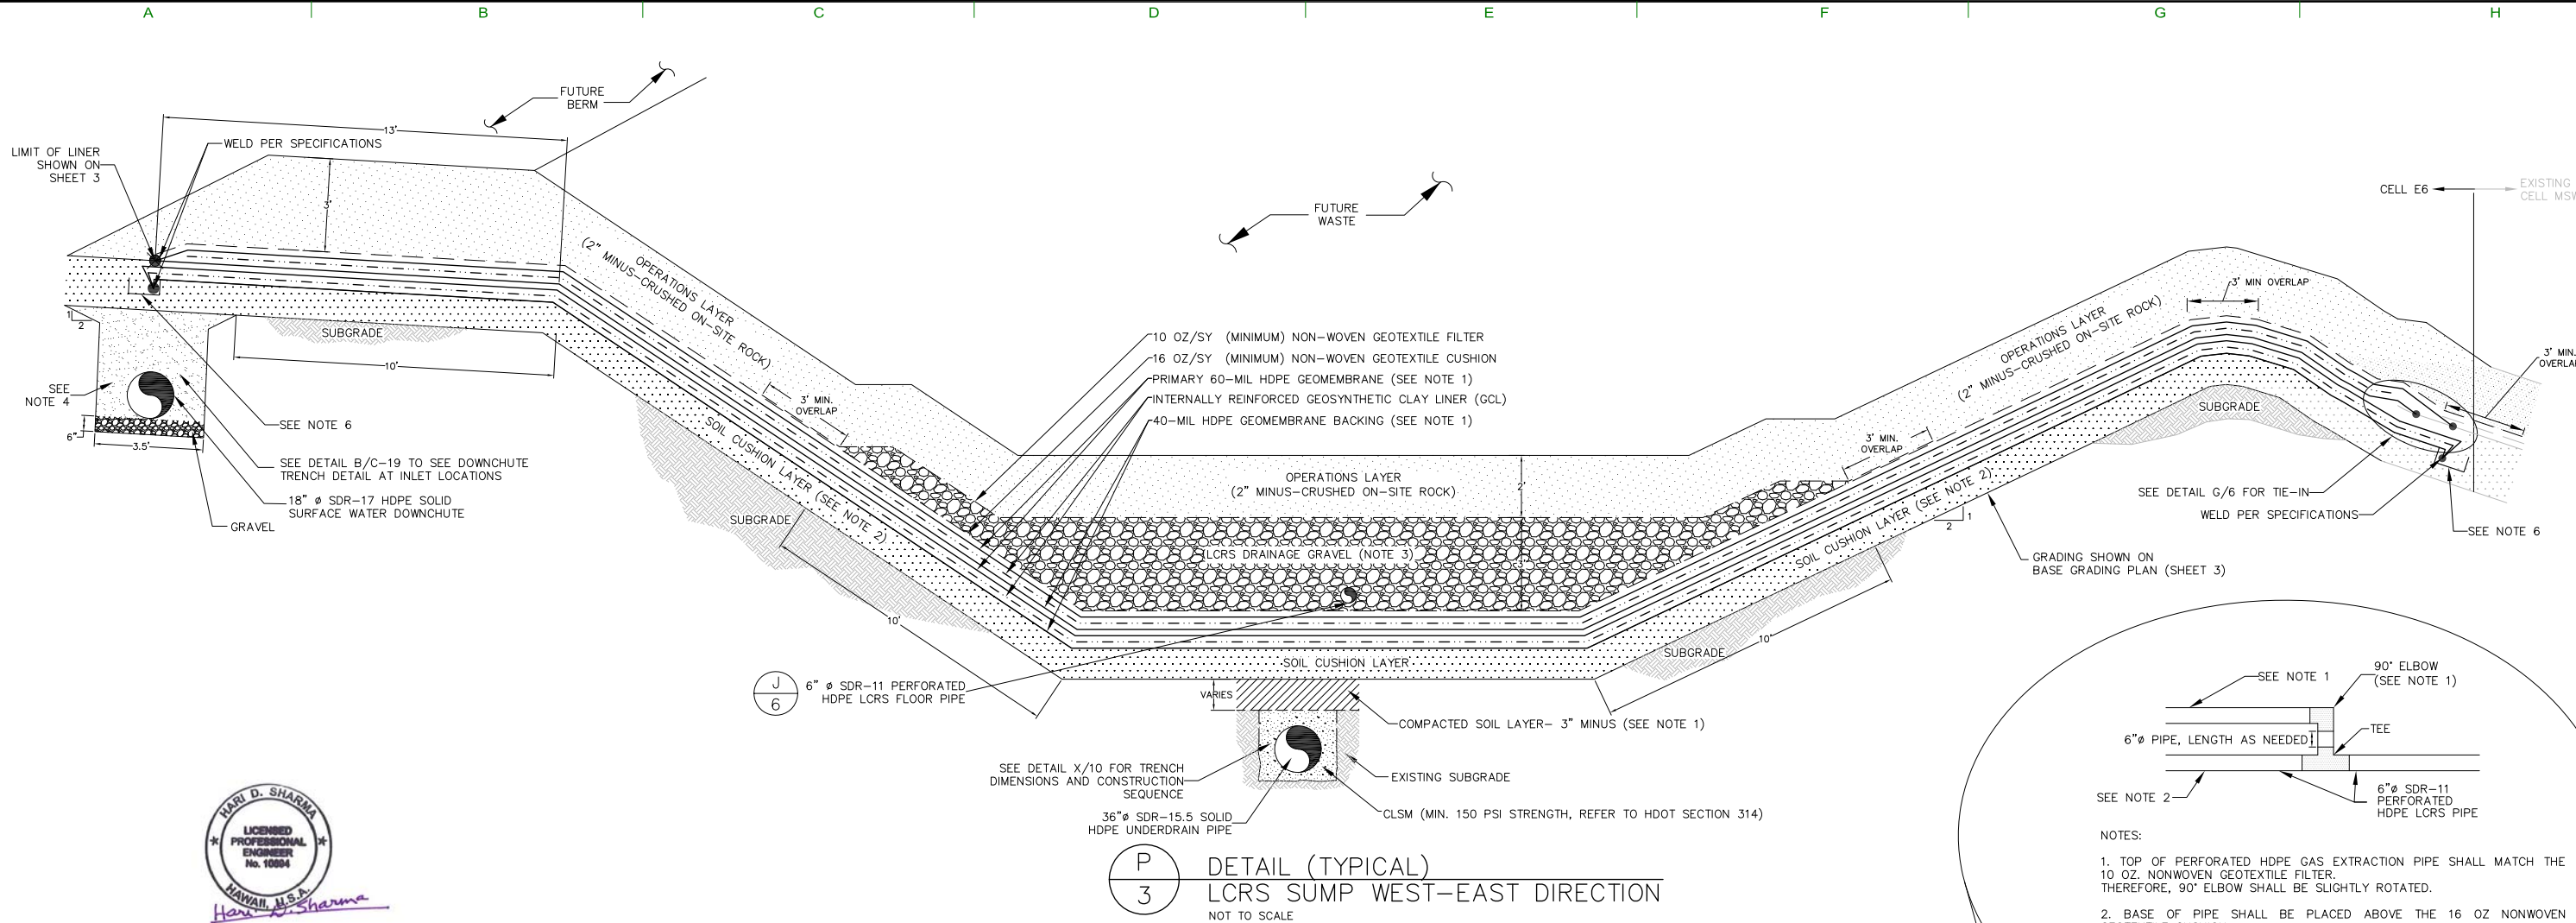

- NOTES:
- FOR ALL CELLS, GEOMEMBRANE SHALL BE TEXTURED ON BOTH SIDES.
  - IF SOIL CUSHION LAYER CAN NOT BE PLACED ON THE SIDE SLOPES, THEN THE SUBGRADE SHALL RECEIVE GUNITE HAVING SURFACE PROJECTIONS LESS THAN 0.25 INCH TO RECEIVE GEOSYNTHETICS.
  - AREA WHERE GRAVEL THICKNESS IS 3 FT AS SHOWN ON SHEET 4.
  - PIPE SOIL BACKFILL SHALL BE SOIL CUSHION MATERIAL (SEE SECTION 02249) OR CONTROLLED LOW STRENGTH MATERIAL (CLSM). MATERIAL AND CONSTRUCTION METHODS FOR CLSM SHALL MEET A MINIMUM STRENGTH OF 150 PSI, AND OTHER REQUIREMENTS IN HDOT SECTION 314. MEASUREMENT AND PAYMENT FOR CLSM IS INCLUDED AS PART OF OTHER BID ITEMS; REFER TO SECTION 1025 OF THE CONTRACT DOCUMENTS.
  - THICKNESS OF COMPACTED SOIL FILL ALONG THE SUBDRAIN PIPE CORRIDOR ALIGNMENT WILL VARY. IN AREAS WHERE COMPACTED SOIL FILL IS REQUIRED TO REACH THE DESIGN BASE GRADES, SOIL SHALL BE PLACED IN ACCORDANCE WITH SECTION 02249 FROM THE TECHNICAL SPECIFICATIONS.
  - INSERT SECONDARY ENCAPSULATED LINER SYSTEM INTO 6" DEEP TERMINATION TRENCH AND BACKFILL WITH COMPACTED SOIL CUSHION.

REVISIONS			
NO.	DESCRIPTION	DATE	BY
1	ADDED POINT OF COMPLIANCE	10 FEB 10	



**Geosyntec**  
consultants

**475 14th Street  
Suite 400  
Oakland, CA 94612**

**CONTAINMENT SYSTEM  
DETAILS IV**


CELLS E5 THROUGH E8  
WAIMANALO GULCH LANDFILL  
EWA BEACH, OAHU, HAWAII

CONSTRUCTION DRAWINGS	
DES BY: ACP	DATE: JANUARY 2010
DRN BY: ACP	SCALE: AS SHOWN
CHK BY: FWS	PROJECT: WL0770
REV BY: HDS	DOCUMENT:
APP BY: HDS	FILE:


SHEET NO.  
**8**



P:\CADD\Land Projects\WMA\Waimanalo\Cell E5-E6 and Pond West Berm Construction\ES-6-DETAILS\CONSTRUCTION LEVEL-REV.dwg 1-13-10 Ching

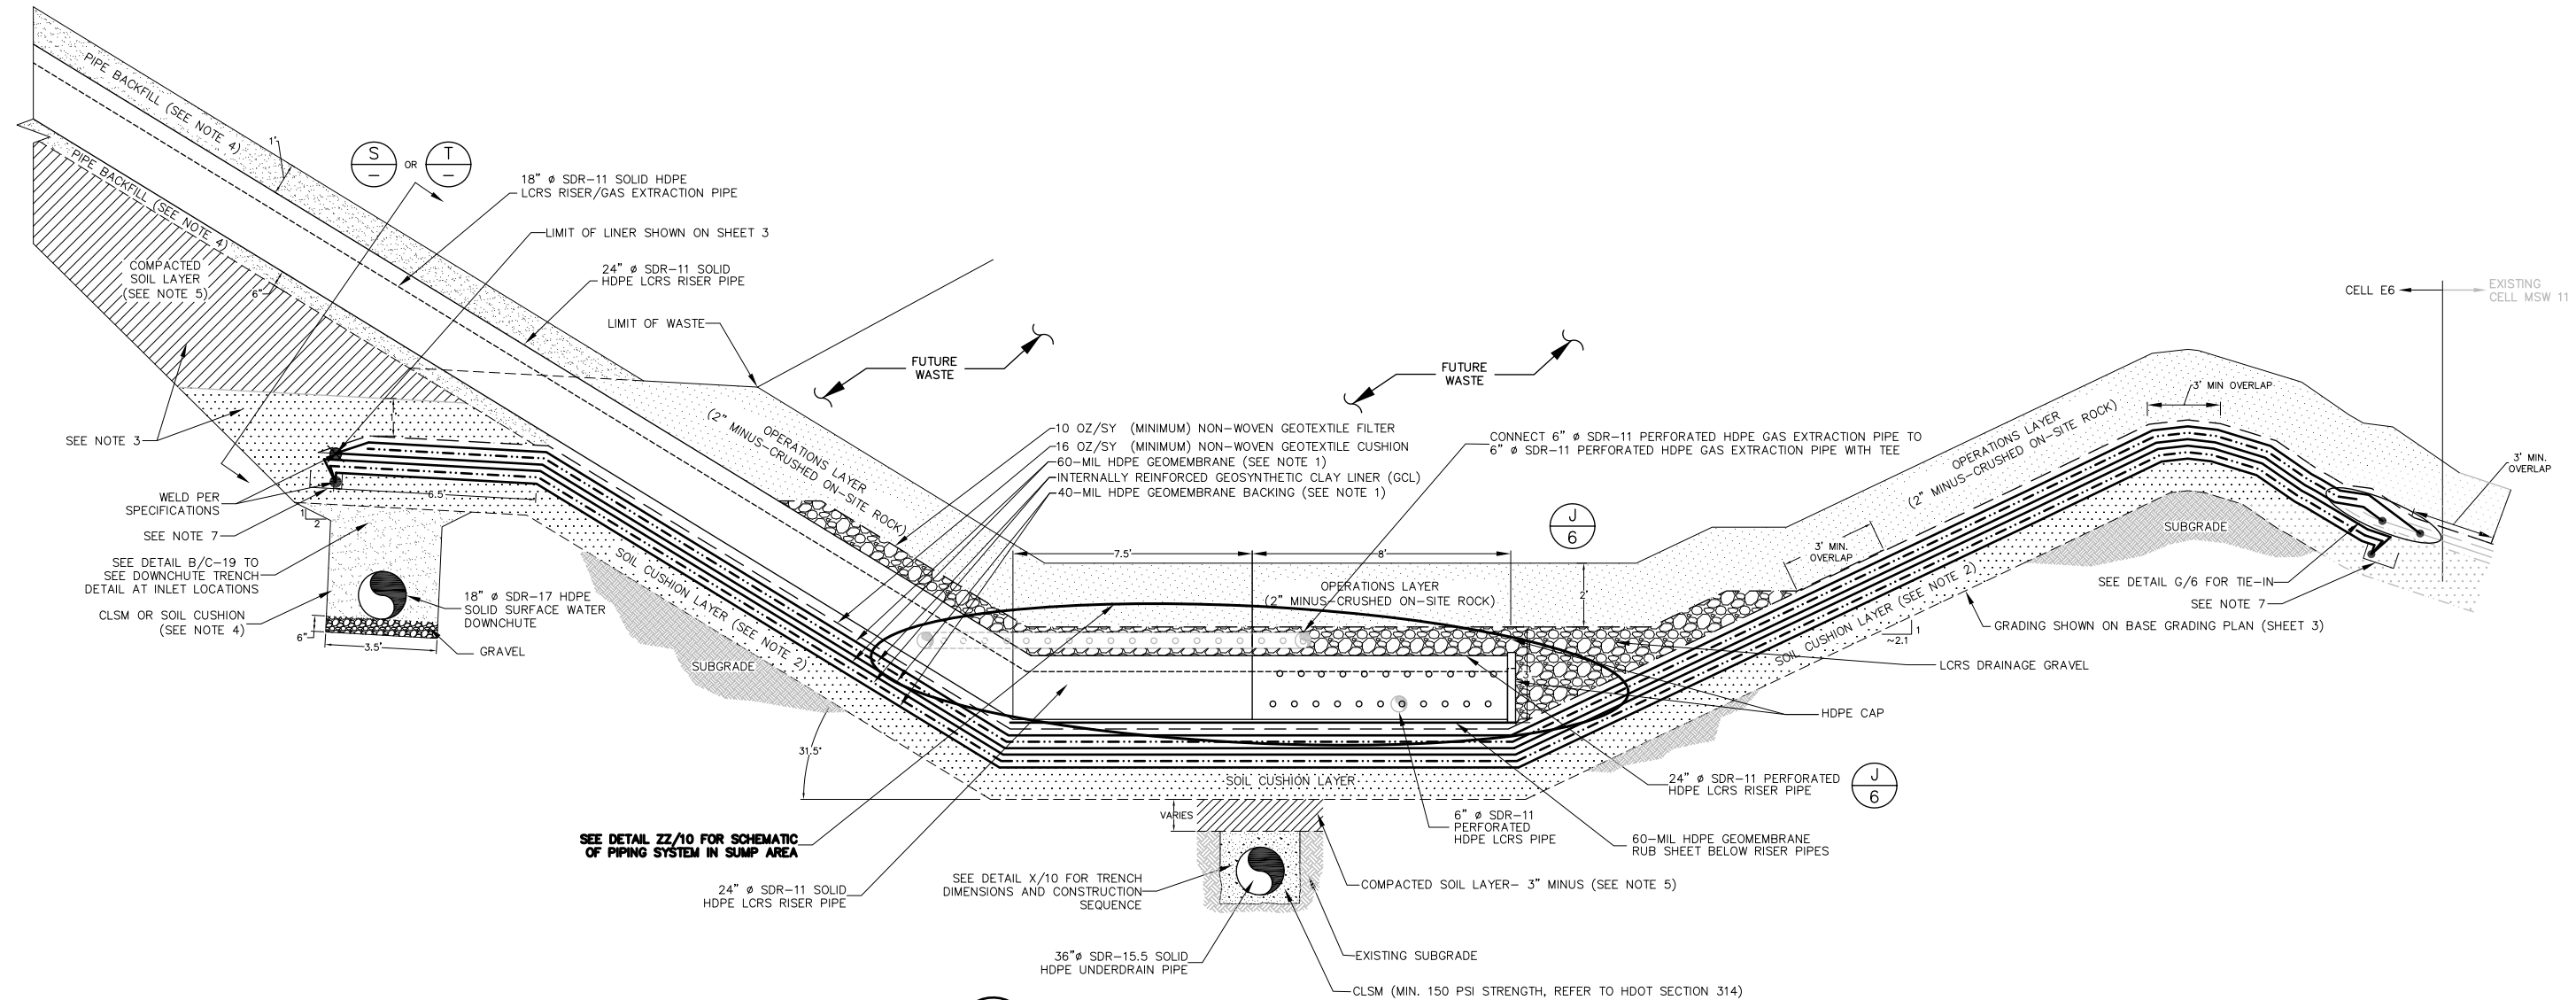


**R**  
**3** **DETAIL (TYPICAL)**  
**LCRS SUMP ALONG LCRS RISER PIPE TRENCH**  
NOT TO SCALE

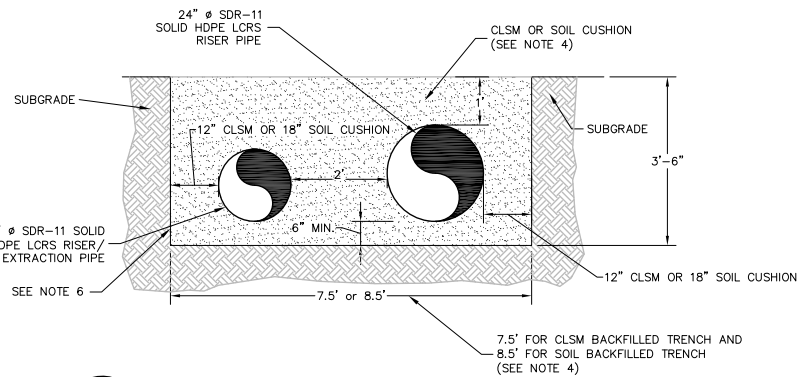

**S**  
**DETAIL (TYPICAL)**  
**LCRS RISER PIPE TRENCH- CUT AREAS**  
**BELOW FUTURE WEST BERM**  
NOT TO SCALE

**NOTES:**

1. FOR ALL CELLS, GEOMEMBRANE SHALL BE TEXTURED ON BOTH SIDES.
2. SOIL CUSHION LAYER SHALL BE 1 FT THICK. IF SOIL CUSHION LAYER CAN NOT BE PLACED ON THE SIDE SLOPES, THEN THE SUBGRADE SHALL RECEIVE GUNITE HAVING SURFACE PROJECTIONS LESS THAN 0.25 INCH TO RECEIVE GEOSYNTHETICS.
3. MATERIAL SHOWN AS FILL. HOWEVER IN SOME AREAS, TRENCH CONSTRUCTION MAY REQUIRE EXCAVATION IN ROCK.
4. MATERIAL AND CONSTRUCTION METHODS FOR CONTROLLED LOW STRENGTH MATERIAL (CLSM) SHALL MEET A MINIMUM STRENGTH OF 150 PSI, AND OTHER REQUIREMENTS IN HDOT SECTION 314. MEASUREMENT AND PAYMENT FOR CLSM IS INCLUDED AS PART OF OTHER BID ITEMS; REFER TO SECTION 1025 OF THE CONTRACT DOCUMENTS.
5. THICKNESS OF COMPACTED SOIL FILL ALONG THE SUBDRAIN PIPE CORRIDOR ALIGNMENT WILL VARY. IN AREAS WHERE COMPACTED SOIL FILL IS REQUIRED TO REACH THE DESIGN BASE GRADES, SOIL SHALL BE PLACED IN ACCORDANCE WITH SECTION 02249 FROM THE TECHNICAL SPECIFICATIONS.
6. CONTRACTOR MAY NEED TO FLATTEN TRENCH SLOPES OR USE SHORING AS REQUIRED.
7. INSERT SECONDARY ENCAPSULATED LINER SYSTEM INTO 6" DEEP TERMINATION TRENCH AND BACKFILL WITH COMPACTED SOIL CUSHION.

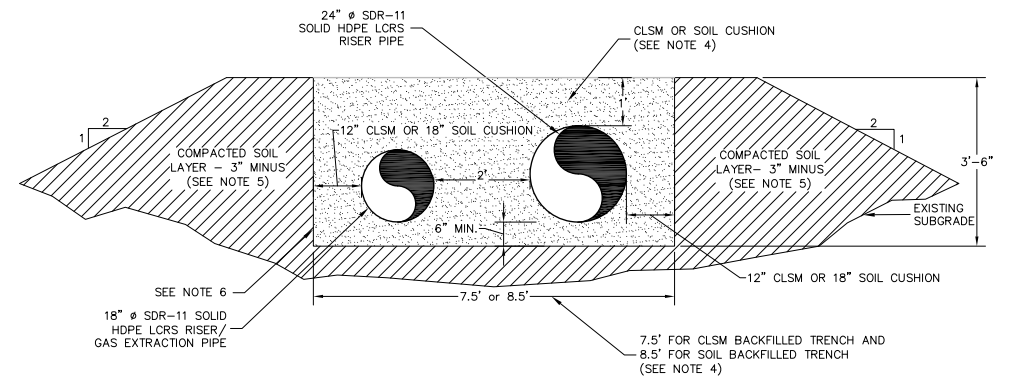

**T**  
**DETAIL (TYPICAL)**  
**LCRS RISER PIPE TRENCH- FILL AREAS**  
**BELOW FUTURE WEST BERM**  
NOT TO SCALE



REVISIONS			
NO.	DESCRIPTION	DATE	BY



**Geosyntec**  
consultants

**475 14th Street**  
**Suite 400**  
**Oakland, CA 94612**

**CONTAINMENT SYSTEM**  
**DETAILS V**

**CELLS E5 THROUGH E8**  
**WAIMANALO GULCH LANDFILL**  
**EWA BEACH, OAHU, HAWAII**


**CONSTRUCTION DRAWINGS**

DES BY: ACP	DATE: JANUARY 2010
DRN BY: ACP	SCALE: AS SHOWN
CHK BY: FWS	PROJECT: WL0770
REV BY: HDS	DOCUMENT:
APP BY: HDS	FILE:


SHEET NO.

9



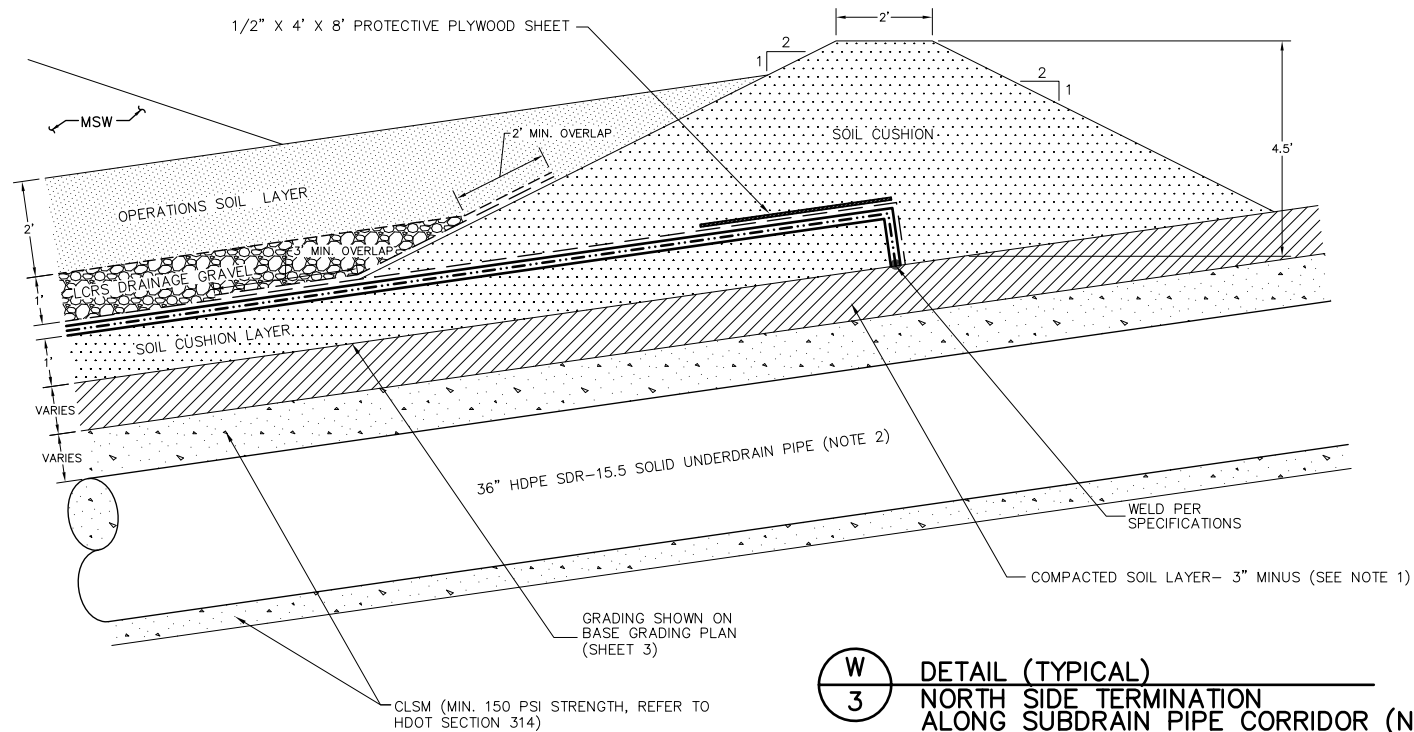


**W  
3** DETAIL (TYPICAL)  
NORTH SIDE TERMINATION  
ALONG SUBDRAIN PIPE CORRIDOR (NOTE 4)  
NOT TO SCALE

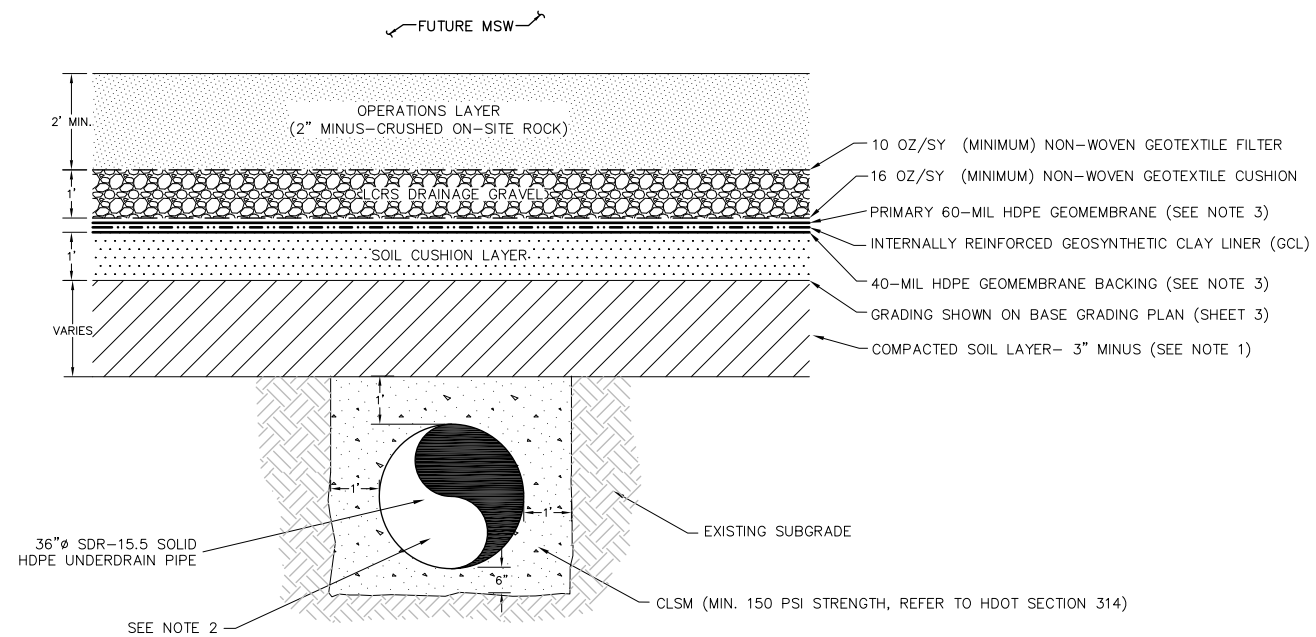

**X  
3** DETAIL (TYPICAL)  
FLOOR CONTAINMENT SYSTEM  
ALONG SUBDRAIN PIPE CORRIDOR  
NOT TO SCALE

NOTES:

1. THICKNESS OF COMPACTED SOIL FILL ALONG THE SUBDRAIN PIPE CORRIDOR ALIGNMENT WILL VARY. IN AREAS WHERE COMPACTED SOIL FILL IS REQUIRED TO REACH THE DESIGN BASE GRADES, SOIL SHALL BE PLACED IN ACCORDANCE WITH SECTION 02249 FROM THE TECHNICAL SPECIFICATIONS.
2. BEFORE CONNECTING TO EXISTING 48" Ø CMP, AND BEFORE BACKFILLING, PIPE SHALL BE TESTED FOR WATER TIGHTNESS AND LEAKS.
3. FOR ALL CELLS, GEOMEMBRANE SHALL BE TEXTURED ON BOTH SIDES.
4. IN CASE CELL IS CONSTRUCTED IN STAGES.

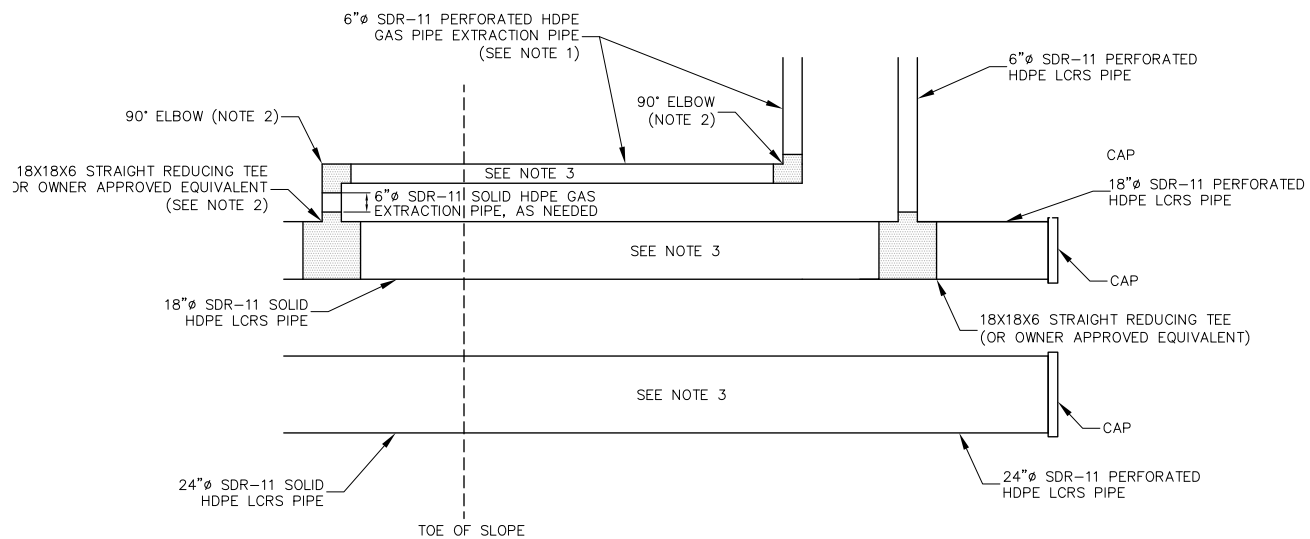

NOTES:

1. TOP OF PIPE SHALL MATCH THE 10 OZ. NONWOVEN GEOTEXTILE FILTER.
2. STRAIGHT REDUCING TEE AND 90° ELBOW SHALL BE SLIGHTLY ROTATED TO ALLOW 6" SOLID GAS PIPE TO BRIDGE THE 6" PERFORATED GAS PIPE TO THE 18" SOLID LCRS RISER.
3. PERFORATED/SOLID PIPE DIMENSIONING SHOWN ON SHEET 9, DETAIL R/3.

**ZZ  
9** PLAN VIEW SCHEMATIC  
NOT TO SCALE



REVISIONS			
NO.	DESCRIPTION	DATE	BY



Geosyntec  
consultants

475 14th Street  
Suite 400  
Oakland, CA 94612

CONTAINMENT SYSTEM  
DETAILS VI

CELLS E5 THROUGH E8  
WAIMANALO GULCH LANDFILL  
EWA BEACH, OAHU, HAWAII


CONSTRUCTION DRAWINGS

DES BY: ACP	DATE: JANUARY 2010
DRN BY: ACP	SCALE: AS SHOWN
CHK BY: FWS	PROJECT: WL0770
REV BY: HDS	DOCUMENT:
APP BY: HDS	FILE:

SHEET NO.

10



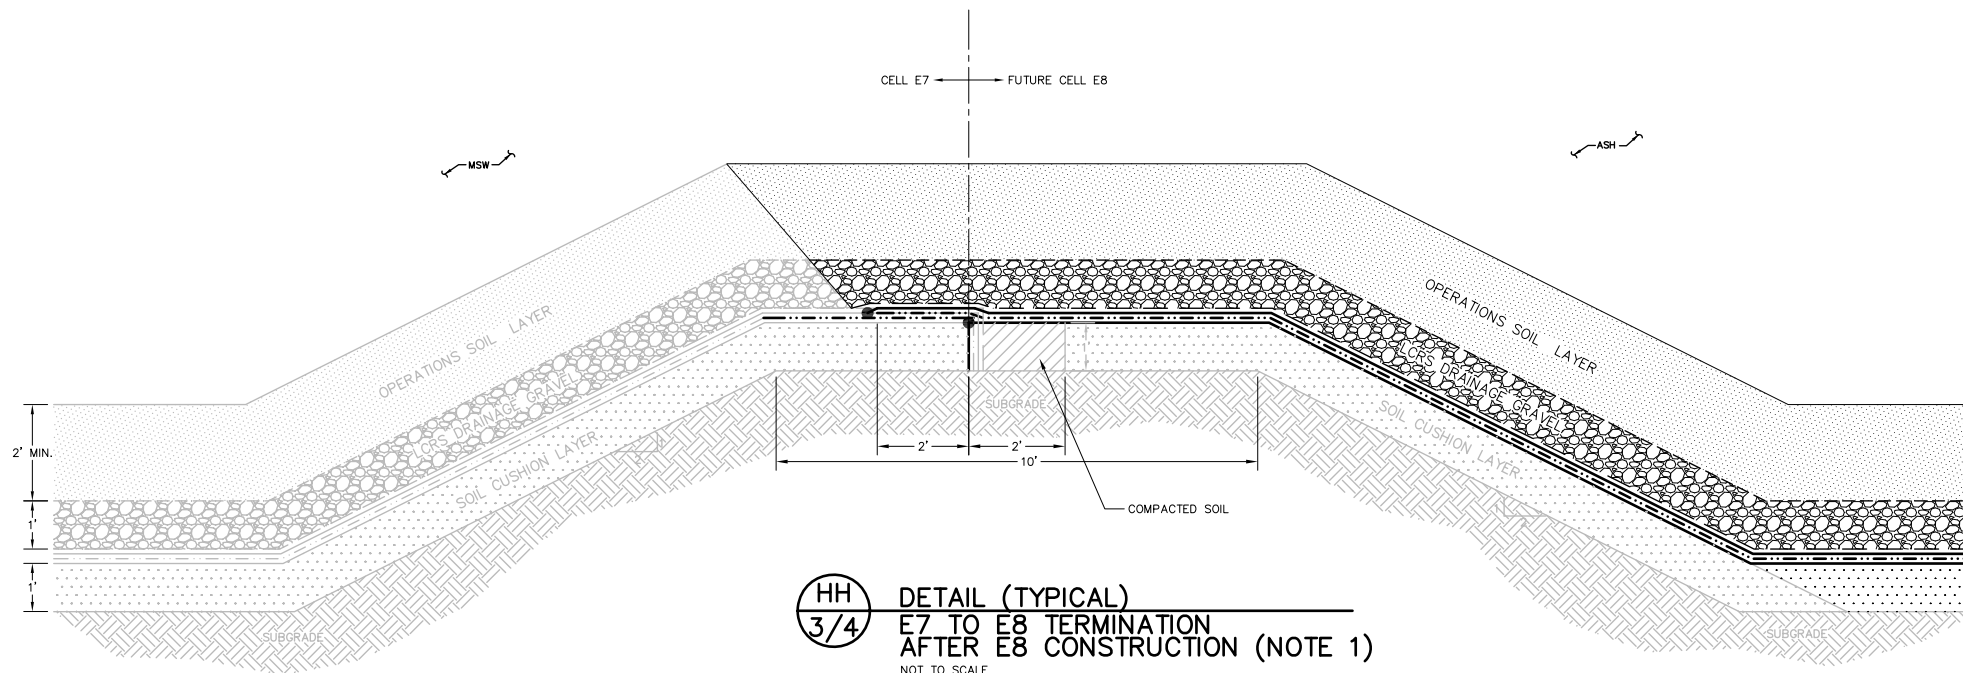

HH  
3/4  
DETAIL (TYPICAL)  
E7 TO E8 TERMINATION  
AFTER E8 CONSTRUCTION (NOTE 1)  
NOT TO SCALE



NOTES:  
1. FOR INITIAL GRADING, BERM WILL BE APPROXIMATELY 10 FT HIGH; FOR LINING, BERM WILL BE REDUCED TO 5 FT HIGH.

P:\CADD\Land Projects\3\WMA\Waimanalo\Jag Cells E5-E6 and Partial West Berm Construction\3-6-DETAILS CONSTRUCTION LEVEL\_REV.dwg 1-13-10 CWing

REVISIONS			
NO.	DESCRIPTION	DATE	BY



Geosyntec  
consultants

475 14th Street  
Suite 400  
Oakland, CA 94612

CONTAINMENT SYSTEM  
DETAILS VII

CELLS E5 THROUGH E8  
WAIMANALO GULCH LANDFILL  
EWA BEACH, OAHU, HAWAII


CONSTRUCTION DRAWINGS

DES BY: ACP	DATE: JANUARY 2010
DRN BY: ACP	SCALE: AS SHOWN
CHK BY: FWS	PROJECT: WL0770
REV BY: HDS	DOCUMENT:
APP BY: HDS	FILE:

SHEET NO.

11



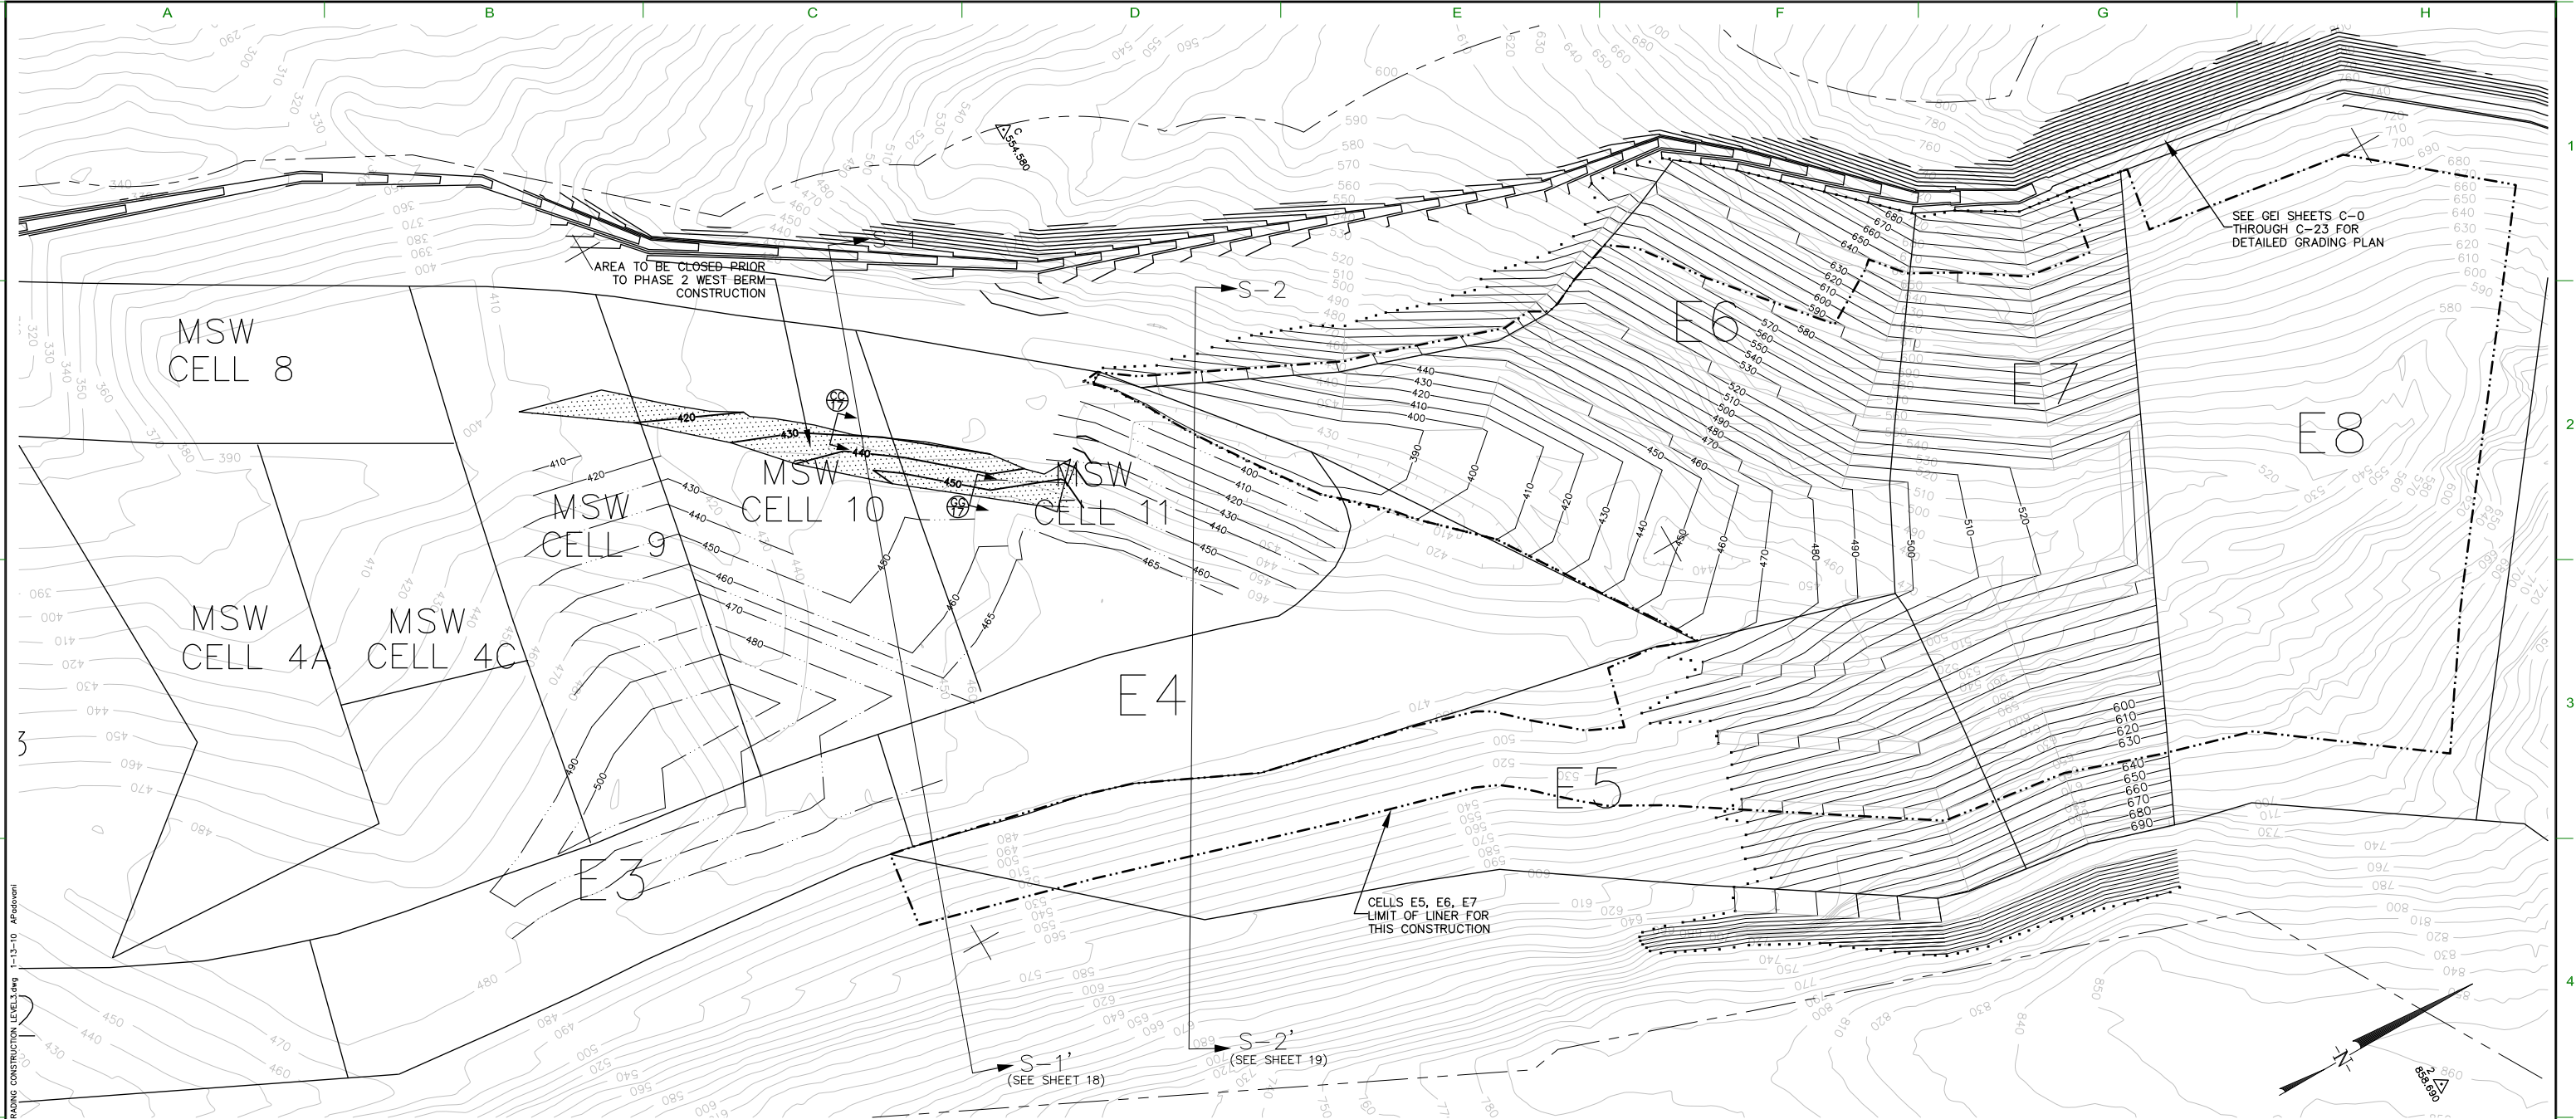

NOTES:


- EXISTING TOPOGRAPHY BASED ON 16 MARCH 2009 AERIAL SURVEY PROVIDED BY OWNER.
- THE LOCATION OF TIE-IN TO EXISTING LINER SHOWN IS APPROXIMATE. ACTUAL LOCATION OF TIE-IN SHOULD BE FIELD VERIFIED PRIOR TO CONSTRUCTION AND MAY VARY FROM LAYOUT SHOWN. CONTRACTOR TO FIELD LOCATE AND UNCOVER EXISTING LINER SYSTEM TERMINATION, AND EXTEND AND CONNECT NEW LINER SYSTEM COMPONENTS TO EXISTING AS NECESSARY TO MAINTAIN LINER SYSTEM CONTINUITY.
- GRADES ALONG TIE-IN MAY BE ADJUSTED AS NEEDED TO MATCH EXISTING SUBGRADE CONDITIONS WITH APPROVAL BY THE ENGINEER.
- FOR VEHICULAR TRAFFIC ON LINER SYSTEM, MINIMUM ALLOWABLE GROUND PRESSURES AND COVER MATERIAL REQUIREMENTS IN THE SPECIFICATIONS TO BE FOLLOWED AT ALL TIMES DURING AND AFTER CONSTRUCTION.
- BEFORE, DURING, AND AFTER STORM EVENTS DURING CONSTRUCTION, CONTRACTOR TO CONTROL AND DIRECT SURFACE WATER RUNOFF BY PUMPING OR OTHER METHODS. CONTRACTOR TO COORDINATE WITH OWNER FOR EROSION CONTROL METHODS.
- BENCHES THAT WILL NOT RECEIVE LINER SHALL BE LOCALLY GRADED SO THAT WATER FLOWS AWAY FROM LANDFILL.
- IF COLLUVIUM OR ALLUVIUM ARE ENCOUNTERED DURING EXCAVATION, SLOPES SHALL BE RE-EVALUATED AND MAY NEED TO BE FLATTENED.
- A SUBDRAIN PIPE MAY BE REQUIRED TO COLLECT SEEPS. SEEPS TO BE IDENTIFIED BY A GEOLOGIST. SUBDRAIN PIPE MAY NEED TO BE EXTENDED PAST THE LIMITS CURRENTLY SHOWN.
- SLOPES SHALL BE EXCAVATED FROM TOP DOWN. CONTRACTOR SHALL ALLOW A GEOLOGIST TO ACCESS THE EXCAVATED SLOPES FOR

NOTES (CONT.):

- GEOLOGIC MAPPING AND TO CONFIRM THAT THE SLOPES WILL BE STABLE.
10. PLACE MSW FILL IN CELLS 9, 10 AND 11, AND CONSTRUCT FINAL COVER TO THE LIMITS SHOWN.
11. A MINIMUM OF THREE DAYS BEFORE STARTING CONSTRUCTION AND AS PART OF MOBILIZATION, CONTRACTOR WITH OWNER/OPERATOR SHALL CLEARLY MARK/IDENTIFY THE LOCATION OF EXISTING UTILITIES AND/OR FACILITIES. EXISTING UTILITIES MAY BE OVERHEAD, ABOVE-GROUND, OR BURIED. EXISTING UTILITIES INCLUDE, BUT ARE NOT LIMITED TO, OVERHEAD POWER LINES AND EXISTING FOUNDATIONS; GROUNDWATER MONITORING WELLS; LANDFILL GAS PROBES; LANDFILL GAS WELLS; SURFACE WATER SAMPLING LOCATIONS; LANDFILL GAS, LANDFILL CONDENSATE, AND LEACHATE PIPELINES; SURFACE CONTROL PIPES; ETC. COORDINATION WITH LOCAL UTILITIES AND/OR A PRIVATE UTILITY LOCATION SERVICE MAY BE REQUIRED. LOCATION OF EXISTING UTILITIES SHALL BE CLEARLY MARKED BY FLAGGED 4-FT HIGH WOODEN STAKES AT 100-FT INTERVALS AND PAINT ON THE GROUND SURFACE. NEARER INTERVALS MAY BE REQUIRED BASED ON FIELD CONDITIONS. CONTRACTOR SHALL MONITOR AND MAINTAIN THE MARKINGS DURING THE CONSTRUCTION PROJECT UNTIL FINAL ACCEPTANCE OF THE WORK BY THE OWNER/OPERATOR.
12. CONTRACTOR SHALL FOLLOW ALL APPLICABLE CITY, STATE AND FEDERAL HEALTH AND SAFETY REQUIREMENTS TO GUARD AND PROTECT ALL WORKERS, PEDESTRIANS, AND THE PUBLIC FROM EXCAVATIONS, BLASTING OPERATIONS, CONSTRUCTION EQUIPMENT, TRAFFIC, CONSTRUCTION OPERATIONS, ALL OBSTRUCTIONS, AND OTHER DANGEROUS ITEMS (E.G., LANDFILL GAS) OR AREAS. A HEALTH AND SAFETY PLAN IS REQUIRED AS PART OF THE WORK.
13. EXPECTED TO BE CONSTRUCTED BETWEEN 2010 AND 2014. CELL BOUNDARY AND/OR LIMIT OF FUTURE WASTE FILL IN CELLS E5 THROUGH E8 MAY CHANGE DEPENDING ON FUTURE WASTE STREAM.

LEGEND

- 440 STAGE 1 MSW GRADES 10-FT CONTOUR (MSL)
- AREA TO BE CLOSED PRIOR TO PHASE 2 WEST BERM
- 480 CELLS E5 THROUGH E7 BASE GRADE 10-FT CONTOUR (MSL)
- 800 EXISTING GROUND 10-FT CONTOUR (MSL)
- 500 CELL E4 WASTE GRADES 10-FT CONTOUR (MSL)
- EXISTING BENCHMARK
- CELL BOUNDARY
- PROPERTY LINE
- APPROXIMATE LIMIT OF EARTHWORK
- APPROXIMATE CELLS E5 THROUGH E8 LINER LIMIT (NOTE 13)
- CROSS SECTION LINE

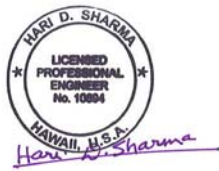

REVISIONS			
NO.	DESCRIPTION	DATE	BY



Geosyntec  
consultants

475 14th Street  
Suite 400  
Oakland, CA 94612

STAGE 1 MSW PLACEMENT  
PRIOR TO PHASE 2 WEST BERM

CELLS E5 THROUGH E8  
WAIMANALO GULCH LANDFILL  
EWA BEACH, OAHU, HAWAII


CONSTRUCTION DRAWINGS

DES BY: ACP	DATE: JANUARY 2010
DRN BY: ACP	SCALE: AS SHOWN
CHK BY: FWS	PROJECT: WL0770
REV BY: HDS	DOCUMENT:
APP BY: HDS	FILE:

SHEET NO.

12



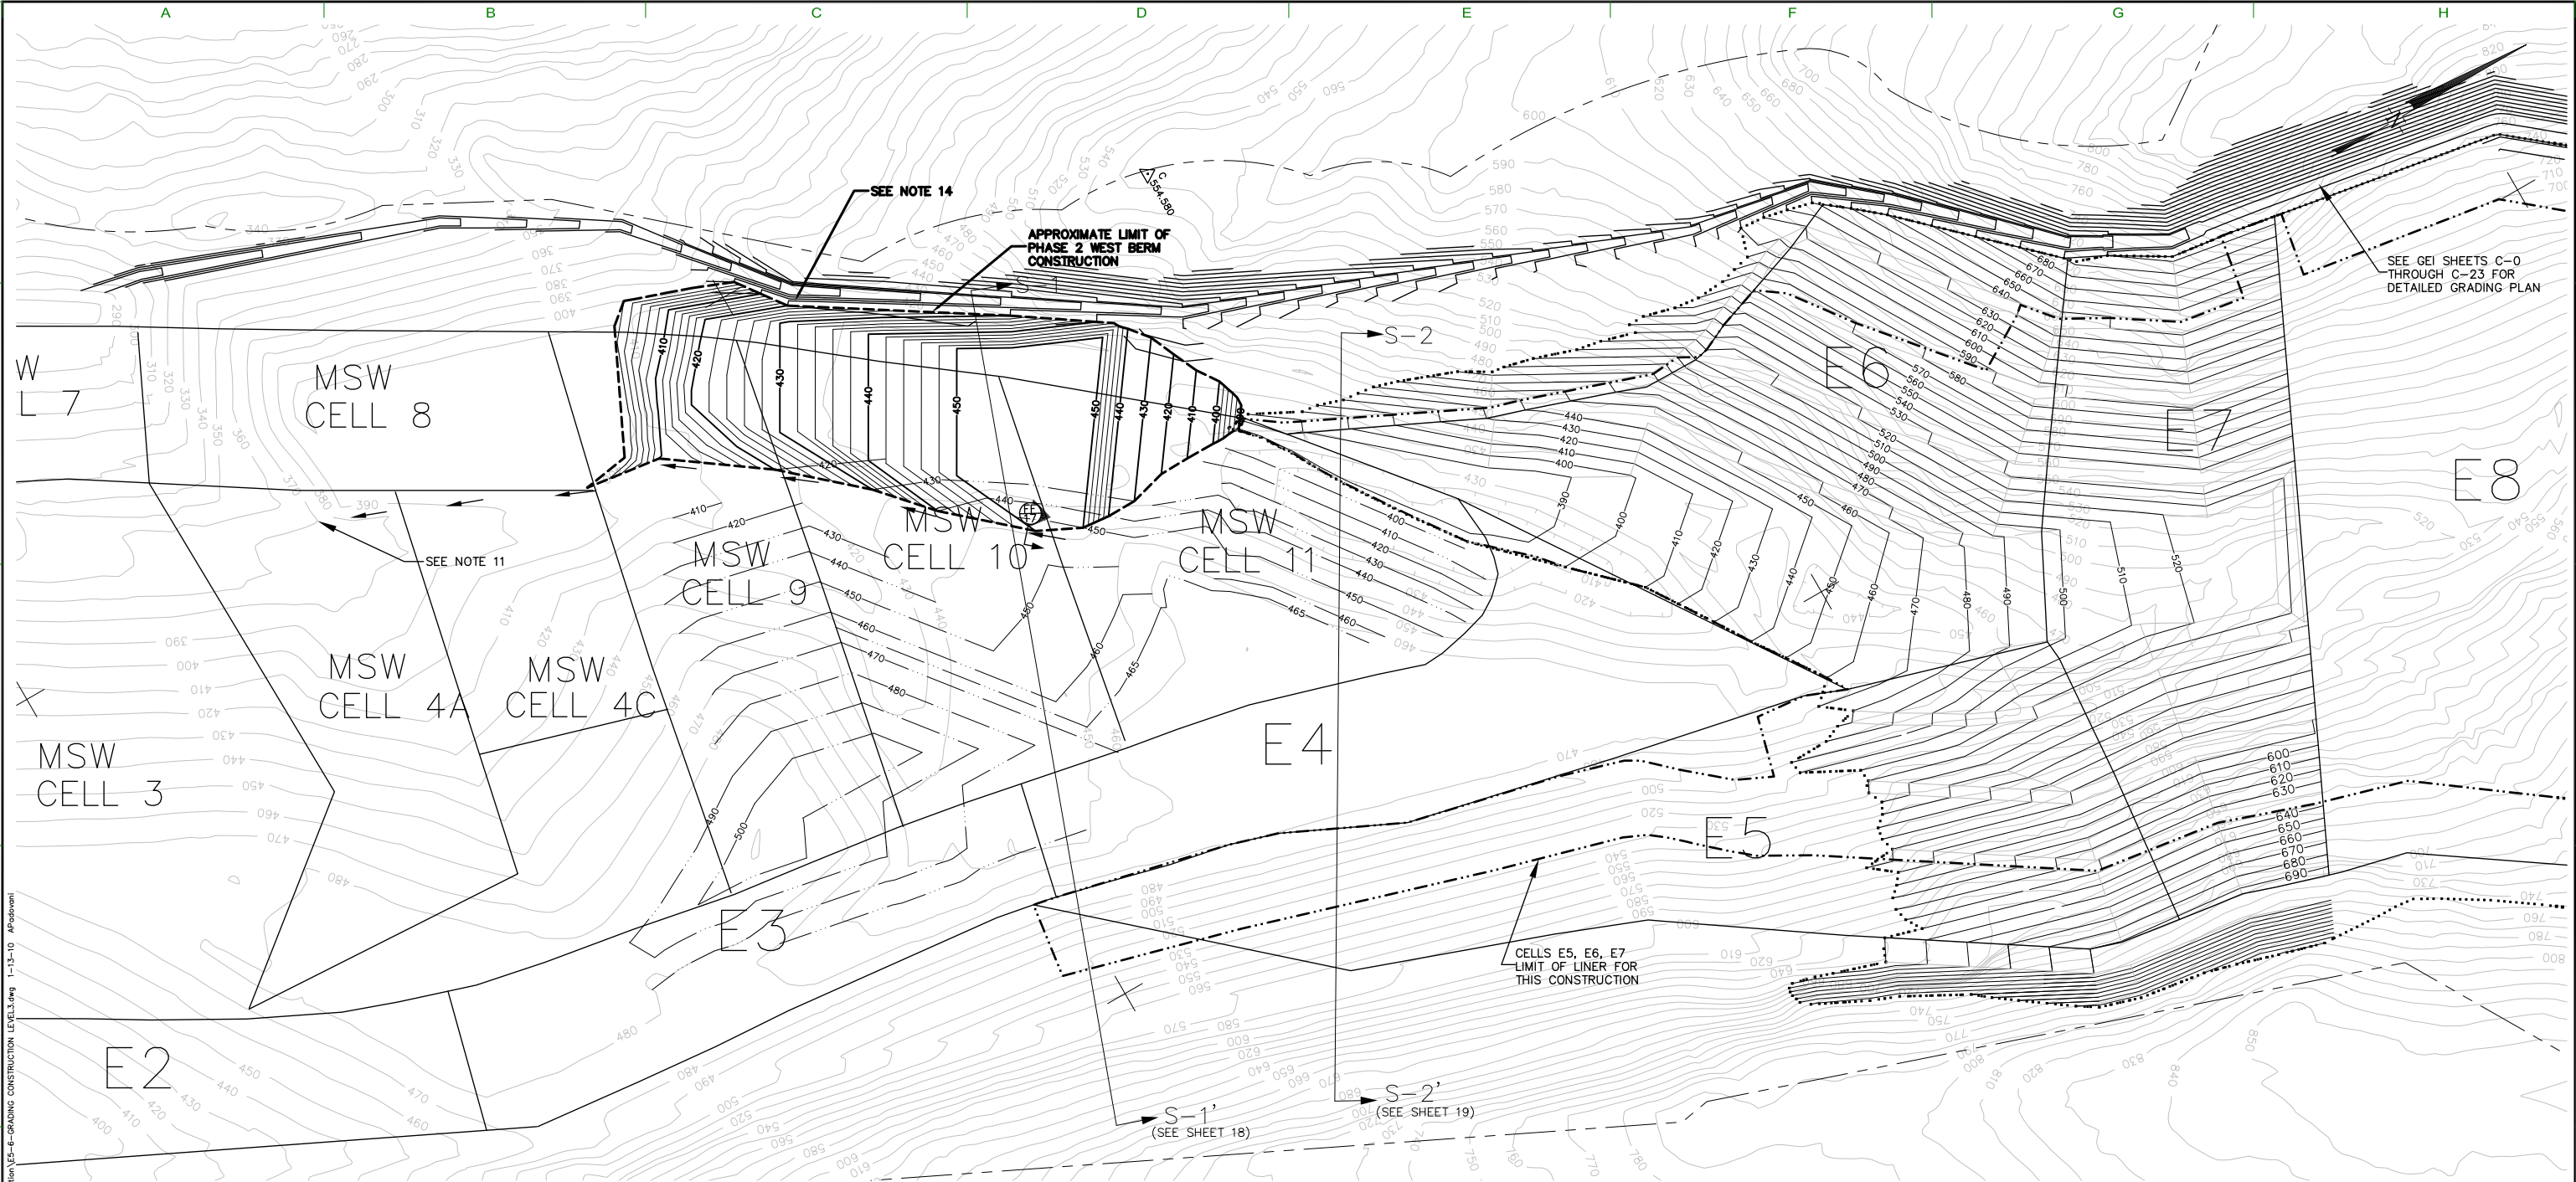


- NOTES:
- EXISTING TOPOGRAPHY BASED ON 16 MARCH 2009 AERIAL SURVEY PROVIDED BY OWNER.
  - THE LOCATION OF TIE-IN TO EXISTING LINER SHOWN IS APPROXIMATE. ACTUAL LOCATION OF TIE-IN SHOULD BE FIELD VERIFIED PRIOR TO CONSTRUCTION AND MAY VARY FROM LAYOUT SHOWN. CONTRACTOR TO FIELD LOCATE AND UNCOVER EXISTING LINER SYSTEM TERMINATION, AND EXTEND AND CONNECT NEW LINER SYSTEM COMPONENTS TO EXISTING AS NECESSARY TO MAINTAIN LINER SYSTEM CONTINUITY.
  - GRADES ALONG TIE-IN MAY BE ADJUSTED AS NEEDED TO MATCH EXISTING SUBGRADE CONDITIONS WITH APPROVAL BY THE ENGINEER.
  - FOR VEHICULAR TRAFFIC ON LINER SYSTEM, MINIMUM ALLOWABLE GROUND PRESSURES AND COVER MATERIAL REQUIREMENTS IN THE SPECIFICATIONS TO BE FOLLOWED AT ALL TIMES DURING AND AFTER CONSTRUCTION.
  - BEFORE, DURING, AND AFTER STORM EVENTS, CONTRACTOR TO CONTROL AND DIRECT SURFACE WATER RUNOFF BY PUMPING OR OTHER METHODS. CONTRACTOR TO COORDINATE WITH OWNER FOR EROSION CONTROL METHODS.
  - BENCHES THAT WILL NOT RECEIVE LINER SHALL BE LOCALLY GRADED SO THAT WATER FLOWS AWAY FROM LANDFILL.
  - SURFACE WATER SWALE SHALL BE BUILT WHERE THE WEST BERM MEETS THE EXISTING MSW. RIPRAP WITH A  $D_{50} = 12$  INCHES SHOULD BE PLACED TO 5 FEET OF EITHER SIDE OF THE INTERSECTION AS PROTECTION AGAINST EROSION. SEE FF/17 FOR CONSTRUCTION DETAIL.
  - THE BERM IS TO BE KEYED INTO THE COMPETENT NATIVE SUBGRADE IN A STEP CONFIGURATION.
  - CONSTRUCT PHASE 2 WEST BERM TO THE GRADES AND LIMITS SHOWN.
  - WASTE FILL CANNOT BE PLACED ABOVE GRADES SHOWN UNTIL PHASE 2 WEST BERM HAS BEEN CONSTRUCTED.

- NOTES (CONT.):
- CONNECT NEW SURFACE WATER SWALE TO EXISTING DRAINAGE FEATURES (I.E. SWALE AND/OR DITCH) TO ENSURE PROPER DISCHARGE.
  - A MINIMUM OF THREE DAYS BEFORE STARTING CONSTRUCTION AND AS PART OF MOBILIZATION, CONTRACTOR WITH OWNER/OPERATOR SHALL CLEARLY MARK/IDENTIFY THE LOCATION OF EXISTING UTILITIES AND/OR FACILITIES. EXISTING UTILITIES MAY BE OVERHEAD, ABOVE-GROUND, OR BURIED. EXISTING UTILITIES INCLUDE, BUT ARE NOT LIMITED TO: OVERHEAD POWER LINES AND EXISTING FOUNDATIONS; GROUNDWATER MONITORING WELLS; LANDFILL GAS PROBES; LANDFILL GAS WELLS; SURFACE WATER SAMPLING LOCATIONS; LANDFILL GAS, LANDFILL CONDENSATE, AND LEACHATE PIPELINES; SURFACE CONTROL PIPES; ETC. COORDINATION WITH LOCAL UTILITIES AND/OR A PRIVATE UTILITY LOCATION SERVICE MAY BE REQUIRED.
- LOCATION OF EXISTING UTILITIES SHALL BE CLEARLY MARKED BY FLAGGED 4-FT HIGH WOODEN STAKES AT 100-FT INTERVALS AND PAINT ON THE GROUND SURFACE. NEARER INTERVALS MAY BE REQUIRED BASED ON FIELD CONDITIONS. CONTRACTOR SHALL MONITOR AND MAINTAIN THE MARKINGS DURING THE CONSTRUCTION PROJECT UNTIL FINAL ACCEPTANCE OF THE WORK BY THE OWNER/OPERATOR.
- CONTRACTOR SHALL FOLLOW ALL APPLICABLE CITY, STATE AND FEDERAL HEALTH AND SAFETY REQUIREMENTS TO GUARD AND PROTECT ALL WORKERS, PEDESTRIANS, AND THE PUBLIC FROM EXCAVATIONS, BLASTING OPERATIONS, CONSTRUCTION EQUIPMENT, TRAFFIC, CONSTRUCTION OPERATIONS, ALL OBSTRUCTIONS, AND OTHER DANGEROUS ITEMS (E.G., LANDFILL GAS) OR AREAS. A HEALTH AND SAFETY PLAN IS REQUIRED AS PART OF THE WORK.
  - CONTRACTOR TO TIE WEST BERM FILL GRADES TO TOPOGRAPHY AND/OR WESTERN DRAINAGE SYSTEM'S RIGHT OF WAY AND PROVIDE AN AS-BUILT SURVEY FOR APPROVAL BY ENGINEER.
  - EXPECTED TO BE CONSTRUCTED BETWEEN 2010 AND 2014. CELL BOUNDARY AND/OR LIMIT OF FUTURE WASTE FILL IN CELLS E5 THROUGH E8 MAY CHANGE DEPENDING ON FUTURE WASTE STREAM.


LEGEND

450	PHASE 2 WEST BERM GRADES 10-FT CONTOUR (MSL)
	PHASE 2 WEST BERM GRADES 2-FT CONTOUR (MSL)
	APPROXIMATE LIMIT OF PHASE 2 WEST BERM
480	CELLS E5 THROUGH E7 BASE GRADE 10-FT CONTOUR (MSL)
800	EXISTING GROUND 10-FT CONTOUR (MSL)
460	EXISTING MSW GRADES PRIOR TO PHASE 2 WEST BERM
4	EXISTING BENCHMARK
	CELL BOUNDARY
	PROPERTY LINE
	APPROXIMATE LIMIT OF EARTHWORK
	APPROXIMATE CELLS E5 THROUGH E8 LINER LIMIT (NOTE 15)
	SURFACE WATER FLOW DIRECTION
S-1	CROSS SECTION LINE

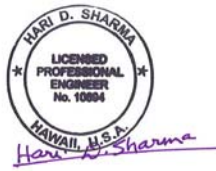

	<b>REVISIONS</b>					<b>Geosyntec</b> consultants	<b>475 14th Street Suite 400 Oakland, CA 94612</b>	<b>PHASE 2 WEST BERM PRIOR TO STAGE 2 MSW PLACEMENT</b>  CELLS E5 THROUGH E8 WAIMANALO GULCH LANDFILL EWA BEACH, OAHU, HAWAII	<b>CONSTRUCTION DRAWINGS</b>		SHEET NO.  <b>13</b>
	NO.	DESCRIPTION	DATE	BY					DES BY: ACP	DATE: JANUARY 2010	
					DRN BY: ACP	SCALE: AS SHOWN			CHK BY: FWS	PROJECT: WL0770	
					REV BY: HDS	DOCUMENT:			APP BY: HDS		
					FILE:						



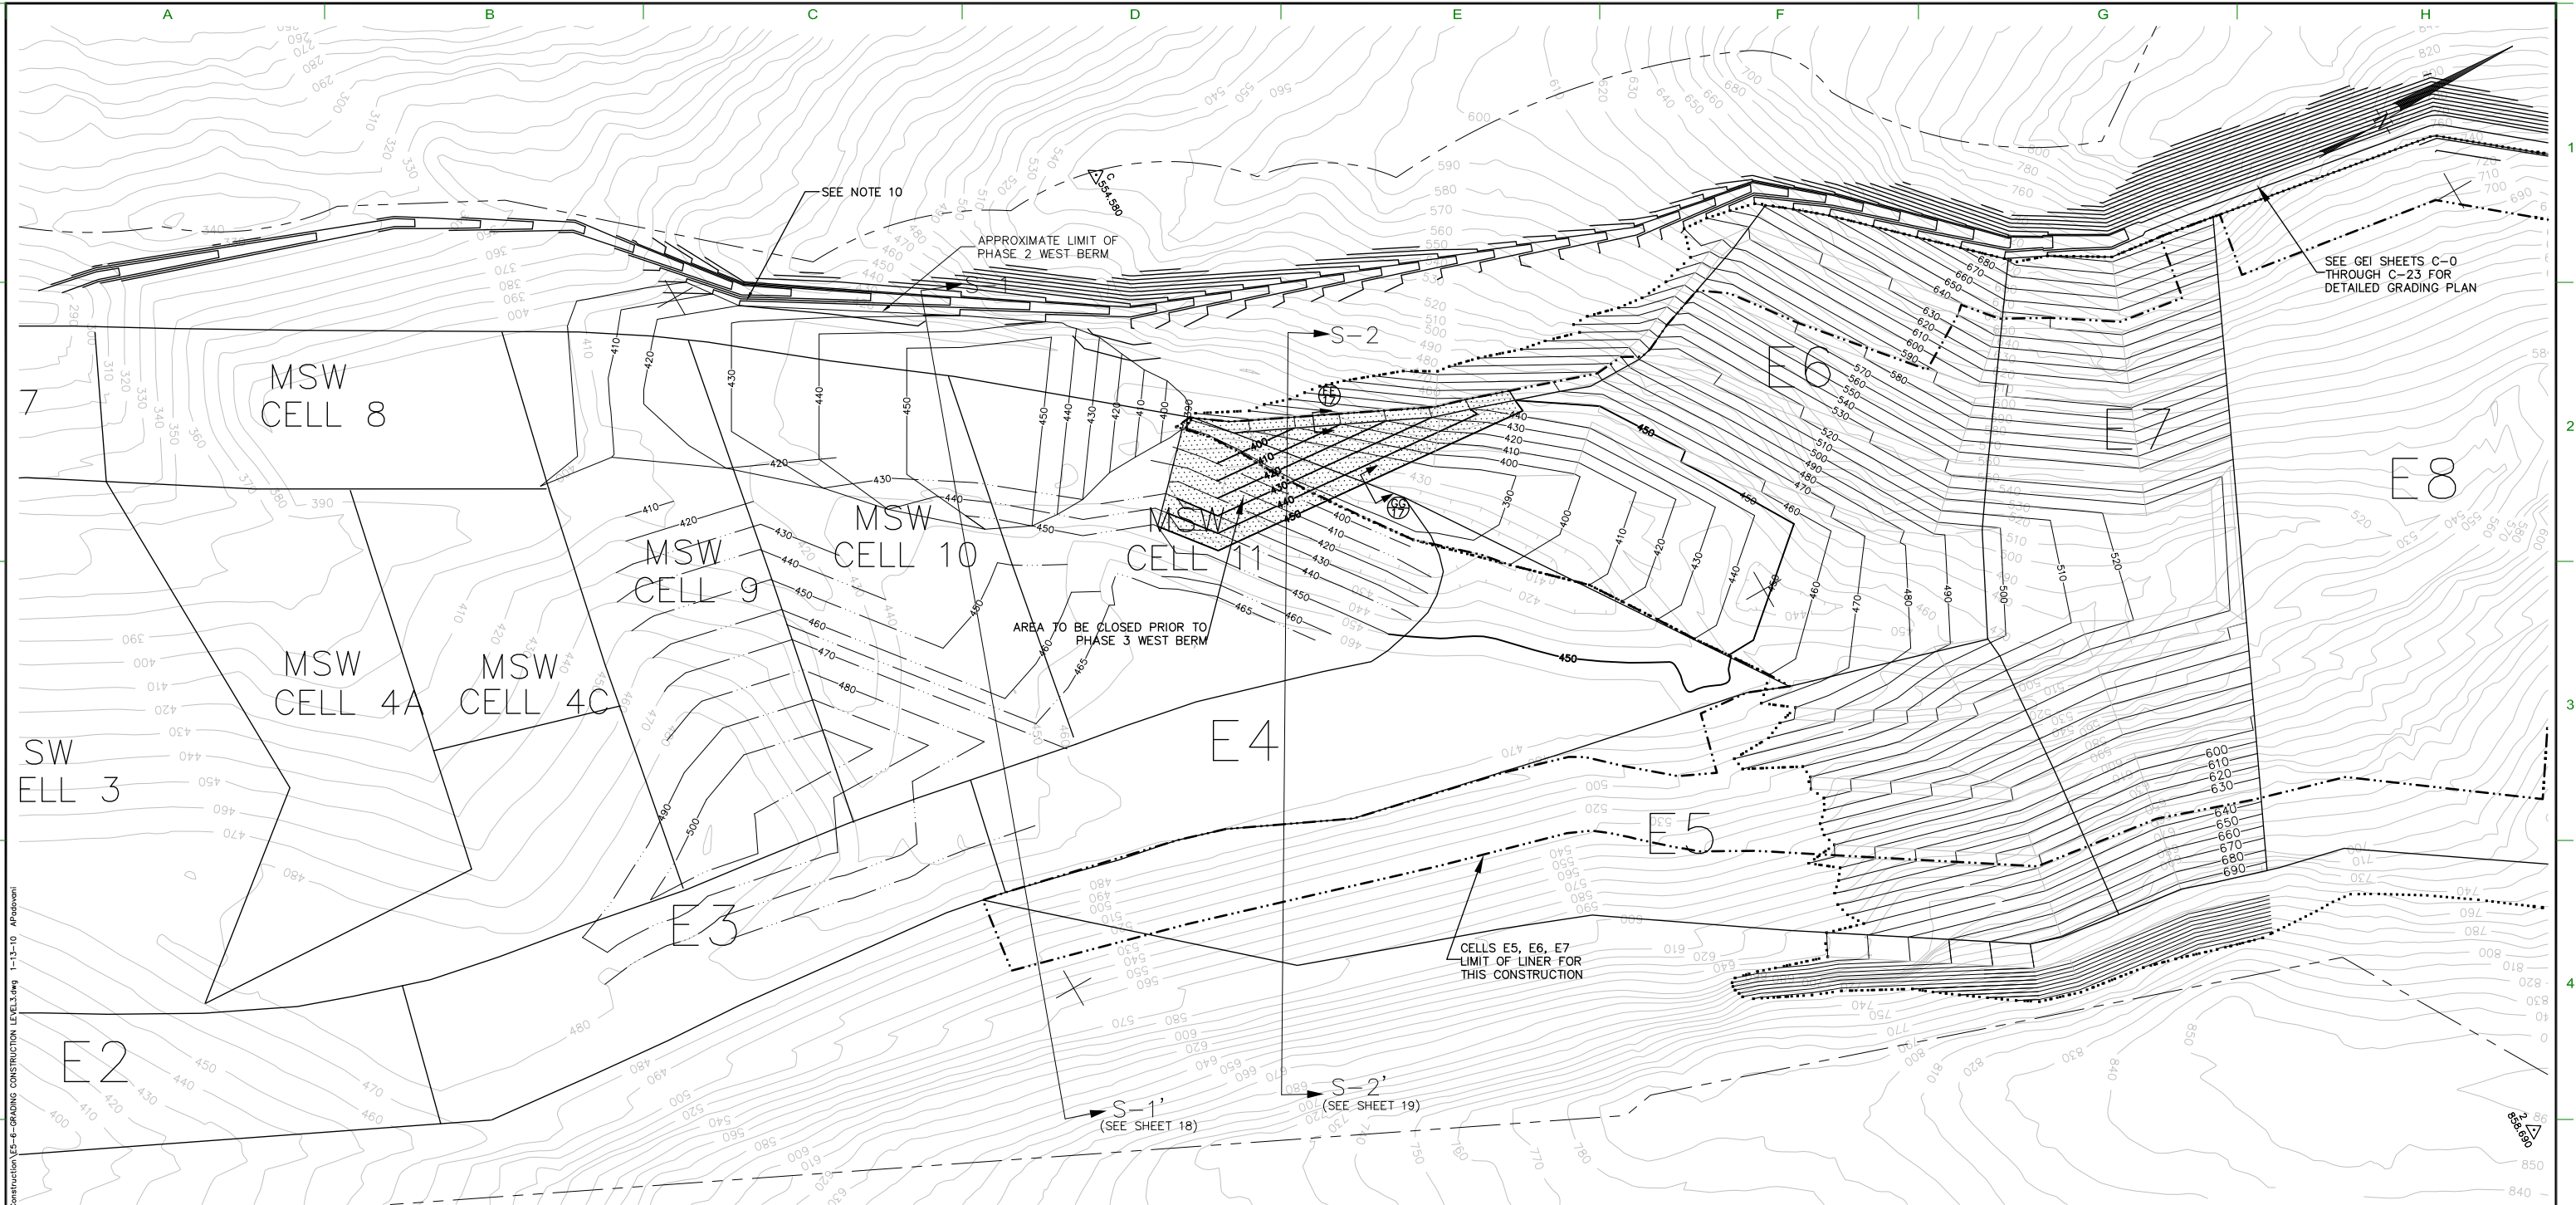

NOTES:


1. EXISTING TOPOGRAPHY BASED ON 16 MARCH 2009 AERIAL SURVEY PROVIDED BY OWNER.
2. THE LOCATION OF TIE-IN TO EXISTING LINER SHOWN IS APPROXIMATE. ACTUAL LOCATION OF TIE-IN SHOULD BE FIELD VERIFIED PRIOR TO CONSTRUCTION AND MAY VARY FROM LAYOUT SHOWN. CONTRACTOR TO FIELD LOCATE AND UNCOVER EXISTING LINER SYSTEM TERMINATION, AND EXTEND AND CONNECT NEW LINER SYSTEM COMPONENTS TO EXISTING AS NECESSARY TO MAINTAIN LINER SYSTEM CONTINUITY.
3. GRADES ALONG TIE-IN MAY BE ADJUSTED AS NEEDED TO MATCH EXISTING SUBGRADE CONDITIONS WITH APPROVAL BY THE ENGINEER.
4. FOR VEHICULAR TRAFFIC ON LINER SYSTEM, MINIMUM ALLOWABLE GROUND PRESSURES AND COVER MATERIAL REQUIREMENTS IN THE SPECIFICATIONS TO BE FOLLOWED AT ALL TIMES DURING AND AFTER CONSTRUCTION.
5. BEFORE, DURING, AND AFTER STORM EVENTS, CONTRACTOR TO CONTROL AND DIRECT SURFACE WATER RUNOFF BY PUMPING OR OTHER METHODS. CONTRACTOR TO COORDINATE WITH OWNER FOR EROSION CONTROL METHODS.
6. BENCHES THAT WILL NOT RECEIVE LINER SHALL BE LOCALLY GRADED SO THAT WATER FLOWS AWAY FROM LANDFILL.
7. PLACE MSW FILL IN CELLS 11 AND E6, AFTER PHASE 2 WEST BERM HAS BEEN CONSTRUCTED, AND CONSTRUCT FINAL COVER TO THE LIMITS SHOWN.
8. A MINIMUM OF THREE DAYS BEFORE STARTING CONSTRUCTION AND AS PART OF MOBILIZATION, CONTRACTOR WITH OWNER/OPERATOR SHALL CLEARLY MARK/IDENTIFY THE LOCATION OF EXISTING UTILITIES AND/OR FACILITIES. EXISTING UTILITIES MAY BE OVERHEAD, ABOVE-

NOTES (CONT.):

- GROUND, OR BURIED. EXISTING UTILITIES INCLUDE, BUT ARE NOT LIMITED TO, OVERHEAD POWER LINES AND EXISTING FOUNDATIONS; GROUNDWATER MONITORING WELLS; LANDFILL GAS PROBES; LANDFILL GAS WELLS; SURFACE WATER SAMPLING LOCATIONS; LANDFILL GAS, LANDFILL CONDENSATE, AND LEACHATE PIPELINES; SURFACE CONTROL PIPES; ETC. COORDINATION WITH LOCAL UTILITIES AND/OR A PRIVATE UTILITY LOCATION SERVICE MAY BE REQUIRED.
- LOCATION OF EXISTING UTILITIES SHALL BE CLEARLY MARKED BY FLAGGED 4-FT HIGH WOODEN STAKES AT 100-FT INTERVALS AND PAINT ON THE GROUND SURFACE. NEARER INTERVALS MAY BE REQUIRED BASED ON FIELD CONDITIONS. CONTRACTOR SHALL MONITOR AND MAINTAIN THE MARKINGS DURING THE CONSTRUCTION PROJECT UNTIL FINAL ACCEPTANCE OF THE WORK BY THE OWNER/OPERATOR.
9. CONTRACTOR SHALL FOLLOW ALL APPLICABLE CITY, STATE AND FEDERAL HEALTH AND SAFETY REQUIREMENTS TO GUARD AND PROTECT ALL WORKERS, PEDESTRIANS, AND THE PUBLIC FROM EXCAVATIONS, BLASTING OPERATIONS, CONSTRUCTION EQUIPMENT, TRAFFIC, CONSTRUCTION OPERATIONS, ALL OBSTRUCTIONS, AND OTHER DANGEROUS ITEMS (E.G., LANDFILL GAS) OR AREAS. A HEALTH AND SAFETY PLAN IS REQUIRED AS PART OF THE WORK.
10. CONTRACTOR TO TIE WEST BERM FILL GRADES TO TOPOGRAPHY AND/OR WESTERN DRAINAGE SYSTEM'S RIGHT OF WAY AND PROVIDE AN AS-BUILT SURVEY FOR APPROVAL BY ENGINEER.
11. EXPECTED TO BE CONSTRUCTED BETWEEN 2010 AND 2014. CELL BOUNDARY AND/OR LIMIT OF FUTURE WASTE FILL IN CELLS E5 THROUGH E8 MAY CHANGE DEPENDING ON FUTURE WASTE STREAM.

LEGEND

- 420— STAGE 2 MSW GRADES 10-FT CONTOUR (MSL)
- 480— AREA TO BE CLOSED PRIOR TO PHASE 3 WEST BERM
- 800— CELLS E5 THROUGH E7 BASE GRADE 10-FT CONTOUR (MSL)
- 440— EXISTING GROUND 10-FT CONTOUR (MSL)
- EXISTING MSW GRADES
- △ 288.16 EXISTING BENCHMARK
- CELL BOUNDARY
- - - PROPERTY LINE
- ..... APPROXIMATE LIMIT OF EARTHWORK
- · - · - APPROXIMATE CELLS E5 THROUGH E8 LINER LIMIT (NOTE 11)
- PHASE 2 WEST BERM GRADES
- ↑ S-1    S-1' ↑ CROSS SECTION LINE

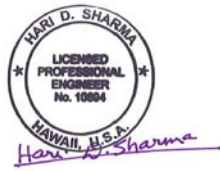

REVISIONS			
NO.	DESCRIPTION	DATE	BY



Geosyntec  
consultants

475 14th Street  
Suite 400  
Oakland, CA 94612

STAGE 2 MSW PLACEMENT  
PRIOR TO PHASE 3 WEST BERM

CELLS E5 THROUGH E8  
WAIMANALO GULCH LANDFILL  
EWA BEACH, OAHU, HAWAII


CONSTRUCTION DRAWINGS

DES BY: ACP	DATE: JANUARY 2010
DRN BY: ACP	SCALE: AS SHOWN
CHK BY: FWS	PROJECT: WL0770
REV BY: HDS	DOCUMENT:
APP BY: HDS	FILE:

SHEET NO.

14



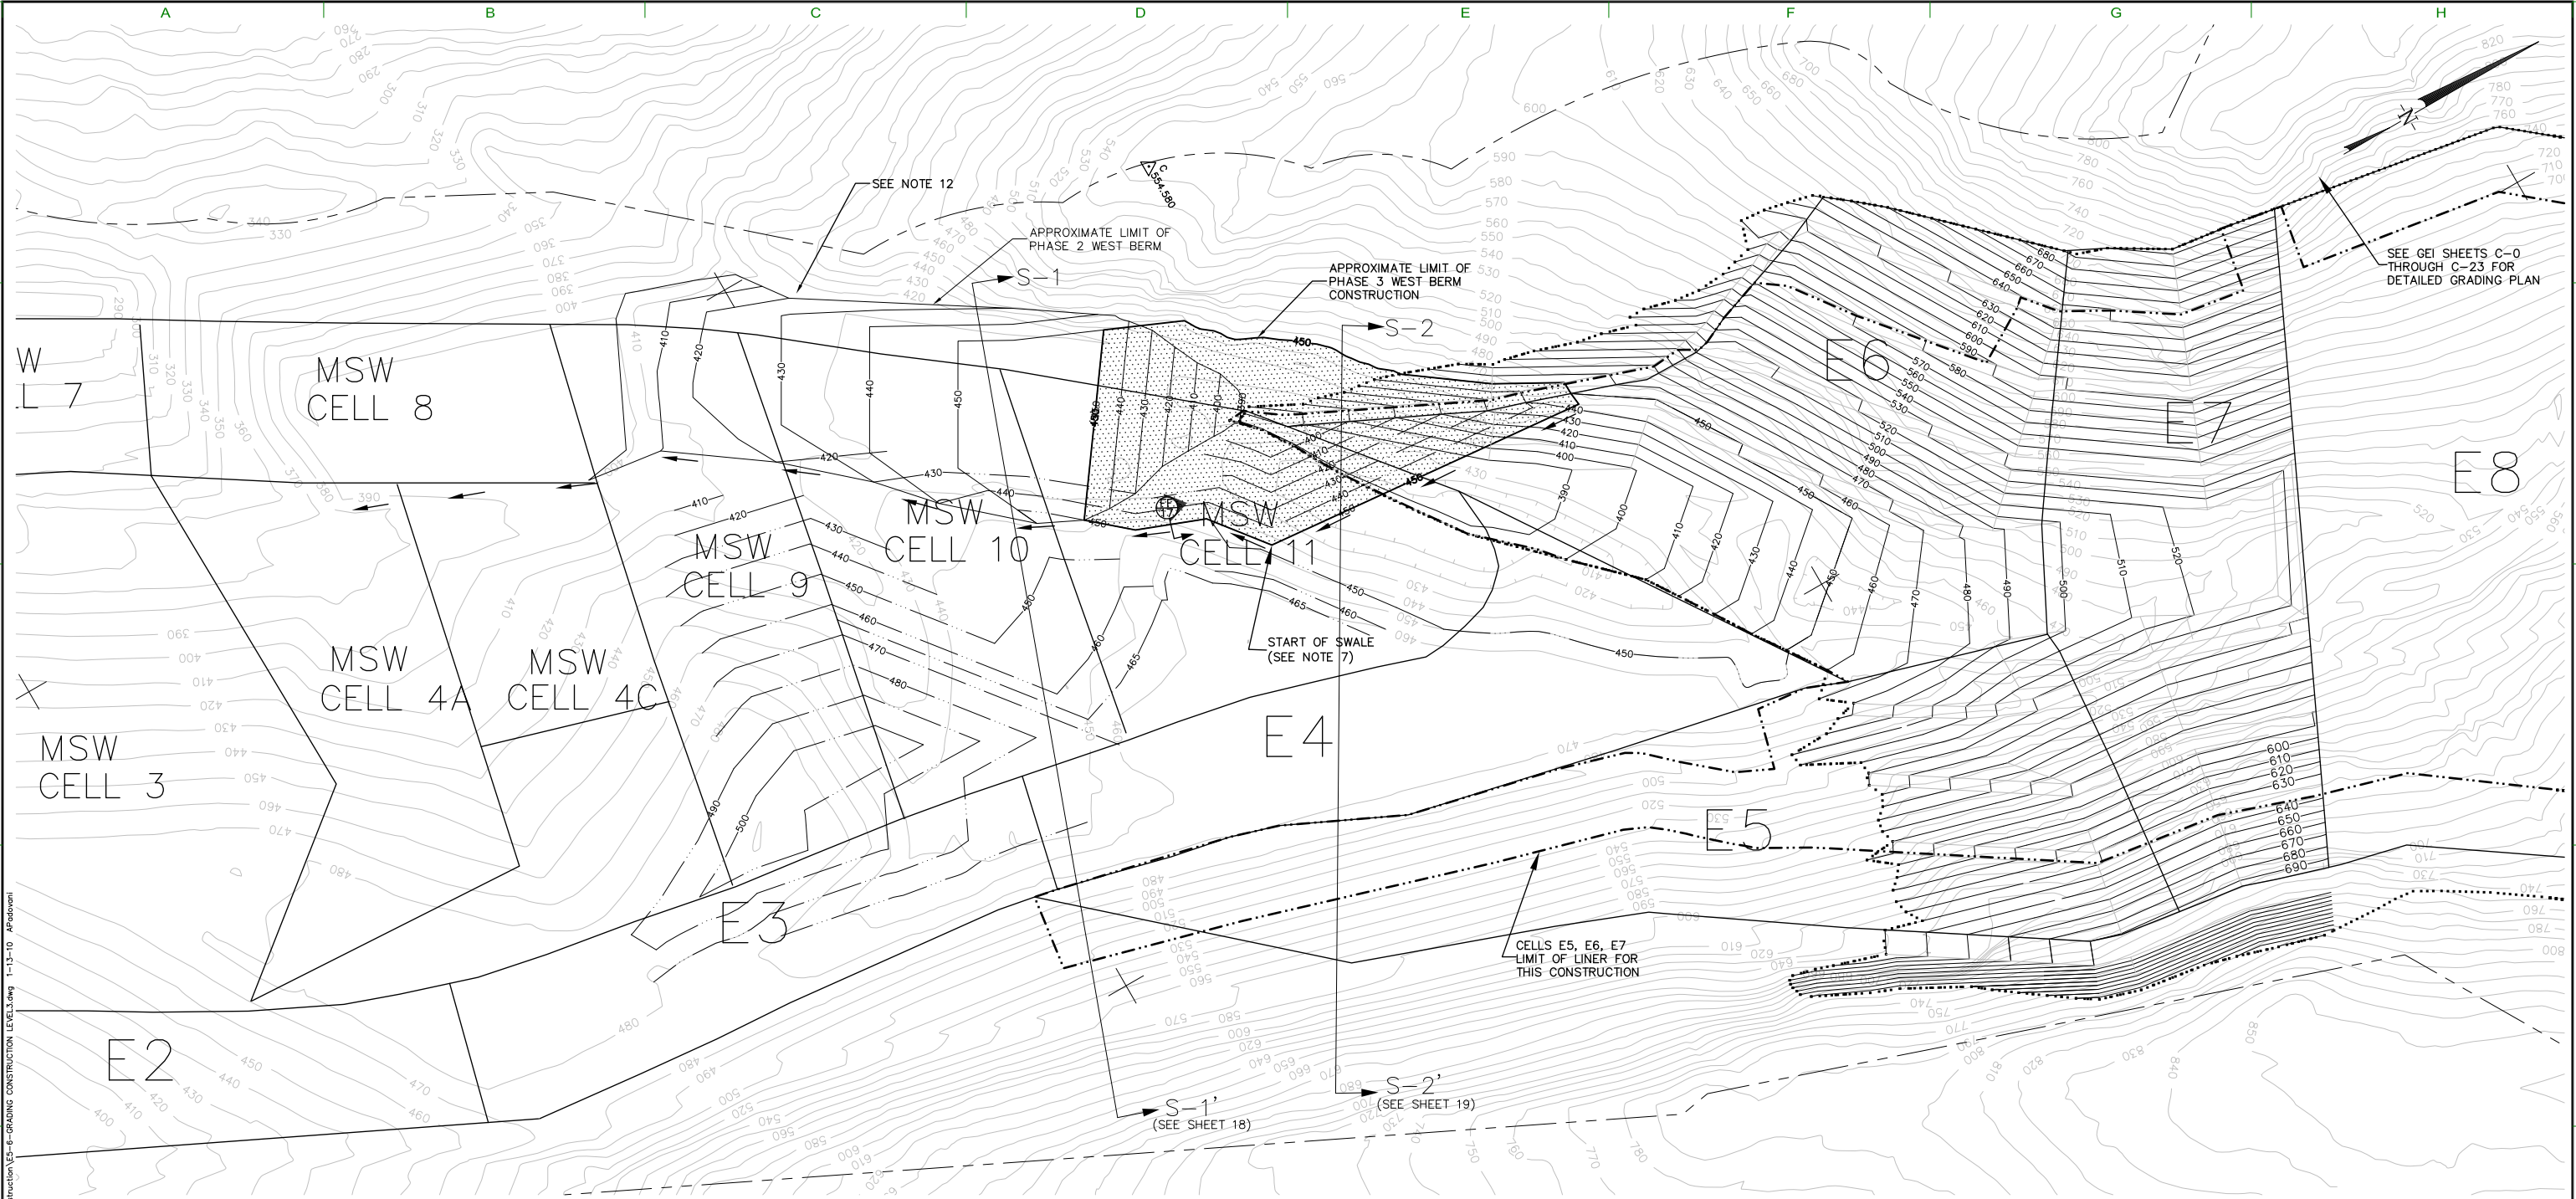

NOTES:

1. EXISTING TOPOGRAPHY BASED ON 16 MARCH 2009 AERIAL SURVEY PROVIDED BY OWNER.
2. THE LOCATION OF TIE-IN TO EXISTING LINER SHOWN IS APPROXIMATE. ACTUAL LOCATION OF TIE-IN SHOULD BE FIELD VERIFIED PRIOR TO CONSTRUCTION AND MAY VARY FROM LAYOUT SHOWN. CONTRACTOR TO FIELD LOCATE AND UNCOVER EXISTING LINER SYSTEM TERMINATION, AND EXTEND AND CONNECT NEW LINER SYSTEM COMPONENTS TO EXISTING AS NECESSARY TO MAINTAIN LINER SYSTEM CONTINUITY.
3. GRADES ALONG TIE-IN MAY BE ADJUSTED AS NEEDED TO MATCH EXISTING SUBGRADE CONDITIONS WITH APPROVAL BY THE ENGINEER.
4. FOR VEHICULAR TRAFFIC ON LINER SYSTEM, MINIMUM ALLOWABLE GROUND PRESSURES AND COVER MATERIAL REQUIREMENTS IN THE SPECIFICATIONS TO BE FOLLOWED AT ALL TIMES DURING AND AFTER CONSTRUCTION.
5. BEFORE, DURING, AND AFTER STORM EVENTS, CONTRACTOR TO CONTROL AND DIRECT SURFACE WATER RUNOFF BY PUMPING OR OTHER METHODS. CONTRACTOR TO COORDINATE WITH OWNER FOR EROSION CONTROL METHODS.
6. BENCHES THAT WILL NOT RECEIVE LINER SHALL BE LOCALLY GRADED SO THAT WATER FLOWS AWAY FROM LANDFILL.
7. SURFACE WATER SWALE SHALL BE BUILT WHERE THE WEST BERM MEETS THE EXISTING MSW. RIPRAP WITH A  $D_{50} = 12$  INCHES SHOULD BE PLACED TO 5 FEET OF EITHER SIDE OF THE INTERSECTION AS PROTECTION AGAINST EROSION. SEE FF/17 FOR CONSTRUCTION DETAIL.
8. THE BERM IS TO BE KEYED INTO THE COMPETENT NATIVE SUBGRADE IN A STEP CONFIGURATION.
9. CONSTRUCT PHASE 3 WEST BERM TO THE GRADES AND LIMITS SHOWN.

NOTES (CONT.):

10. A MINIMUM OF THREE DAYS BEFORE STARTING CONSTRUCTION AND AS PART OF MOBILIZATION, CONTRACTOR WITH OWNER/OPERATOR SHALL CLEARLY MARK/IDENTIFY THE LOCATION OF EXISTING UTILITIES AND/OR FACILITIES. EXISTING UTILITIES MAY BE OVERHEAD, ABOVE-GROUND, OR BURIED. EXISTING UTILITIES INCLUDE, BUT ARE NOT LIMITED TO, OVERHEAD POWER LINES AND EXISTING FOUNDATIONS; GROUNDWATER MONITORING WELLS; LANDFILL GAS PROBES; LANDFILL GAS WELLS; SURFACE WATER SAMPLING LOCATIONS; LANDFILL GAS, LANDFILL CONDENSATE, AND LEACHATE PIPELINES; SURFACE CONTROL PIPES; ETC. COORDINATION WITH LOCAL UTILITIES AND/OR A PRIVATE UTILITY LOCATION SERVICE MAY BE REQUIRED.
- LOCATION OF EXISTING UTILITIES SHALL BE CLEARLY MARKED BY FLAGGED 4-FT HIGH WOODEN STAKES AT 100-FT INTERVALS AND PAINT ON THE GROUND SURFACE. NEARER INTERVALS MAY BE REQUIRED BASED ON FIELD CONDITIONS. CONTRACTOR SHALL MONITOR AND MAINTAIN THE MARKINGS DURING THE CONSTRUCTION PROJECT UNTIL FINAL ACCEPTANCE OF THE WORK BY THE OWNER/OPERATOR.
11. CONTRACTOR SHALL FOLLOW ALL APPLICABLE CITY, STATE AND FEDERAL HEALTH AND SAFETY REQUIREMENTS TO GUARD AND PROTECT ALL WORKERS, PEDESTRIANS, AND THE PUBLIC FROM EXCAVATIONS, BLASTING OPERATIONS, CONSTRUCTION EQUIPMENT, TRAFFIC, CONSTRUCTION OPERATIONS, ALL OBSTRUCTIONS, AND OTHER DANGEROUS ITEMS (E.G., LANDFILL GAS) OR AREAS. A HEALTH AND SAFETY PLAN IS REQUIRED AS PART OF THE WORK.
12. CONTRACTOR TO TIE WEST BERM FILL GRADES TO TOPOGRAPHY AND/OR WESTERN DRAINAGE SYSTEM'S RIGHT OF WAY AND PROVIDE AN AS-BUILT SURVEY FOR APPROVAL BY ENGINEER.
13. EXPECTED TO BE CONSTRUCTED BETWEEN 2010 AND 2014. CELL BOUNDARY AND/OR LIMIT OF FUTURE WASTE FILL IN CELLS E5 THROUGH E8 MAY CHANGE DEPENDING ON FUTURE WASTE STREAM.

LEGEND

- 450 PHASE 3 WEST BERM GRADES 10-FT CONTOUR (MSL)
- 480 APPROXIMATE LIMIT OF PHASE 3 WEST BERM
- 800 CELLS E5 THROUGH E7 BASE GRADE 10-FT CONTOUR (MSL)
- 440 EXISTING GROUND 10-FT CONTOUR (MSL)
- 288.16 EXISTING MSW GRADES PRIOR TO PHASE 3 WEST BERM
- EXISTING BENCHMARK
- CELL BOUNDARY
- PROPERTY LINE
- APPROXIMATE LIMIT OF EARTHWORK
- APPROXIMATE CELLS E5 THROUGH E7 LINER LIMIT (NOTE 13)
- PHASE 2 WEST BERM GRADES
- SURFACE WATER FLOW DIRECTION
- CROSS SECTION LINE



REVISIONS			
NO.	DESCRIPTION	DATE	BY



Geosyntec  
consultants

475 14th Street  
Suite 400  
Oakland, CA 94612

PHASE 3 WEST BERM PRIOR TO  
STAGE 3 MSW PLACEMENT

CELLS E5 THROUGH E8  
WAIMANALO GULCH LANDFILL  
EWA BEACH, OAHU, HAWAII


CONSTRUCTION DRAWINGS

DES BY: ACP	DATE: JANUARY 2010
DRN BY: ACP	SCALE: AS SHOWN
CHK BY: FWS	PROJECT: WL0770
REV BY: HDS	DOCUMENT:
APP BY: HDS	FILE:

SHEET NO.

15



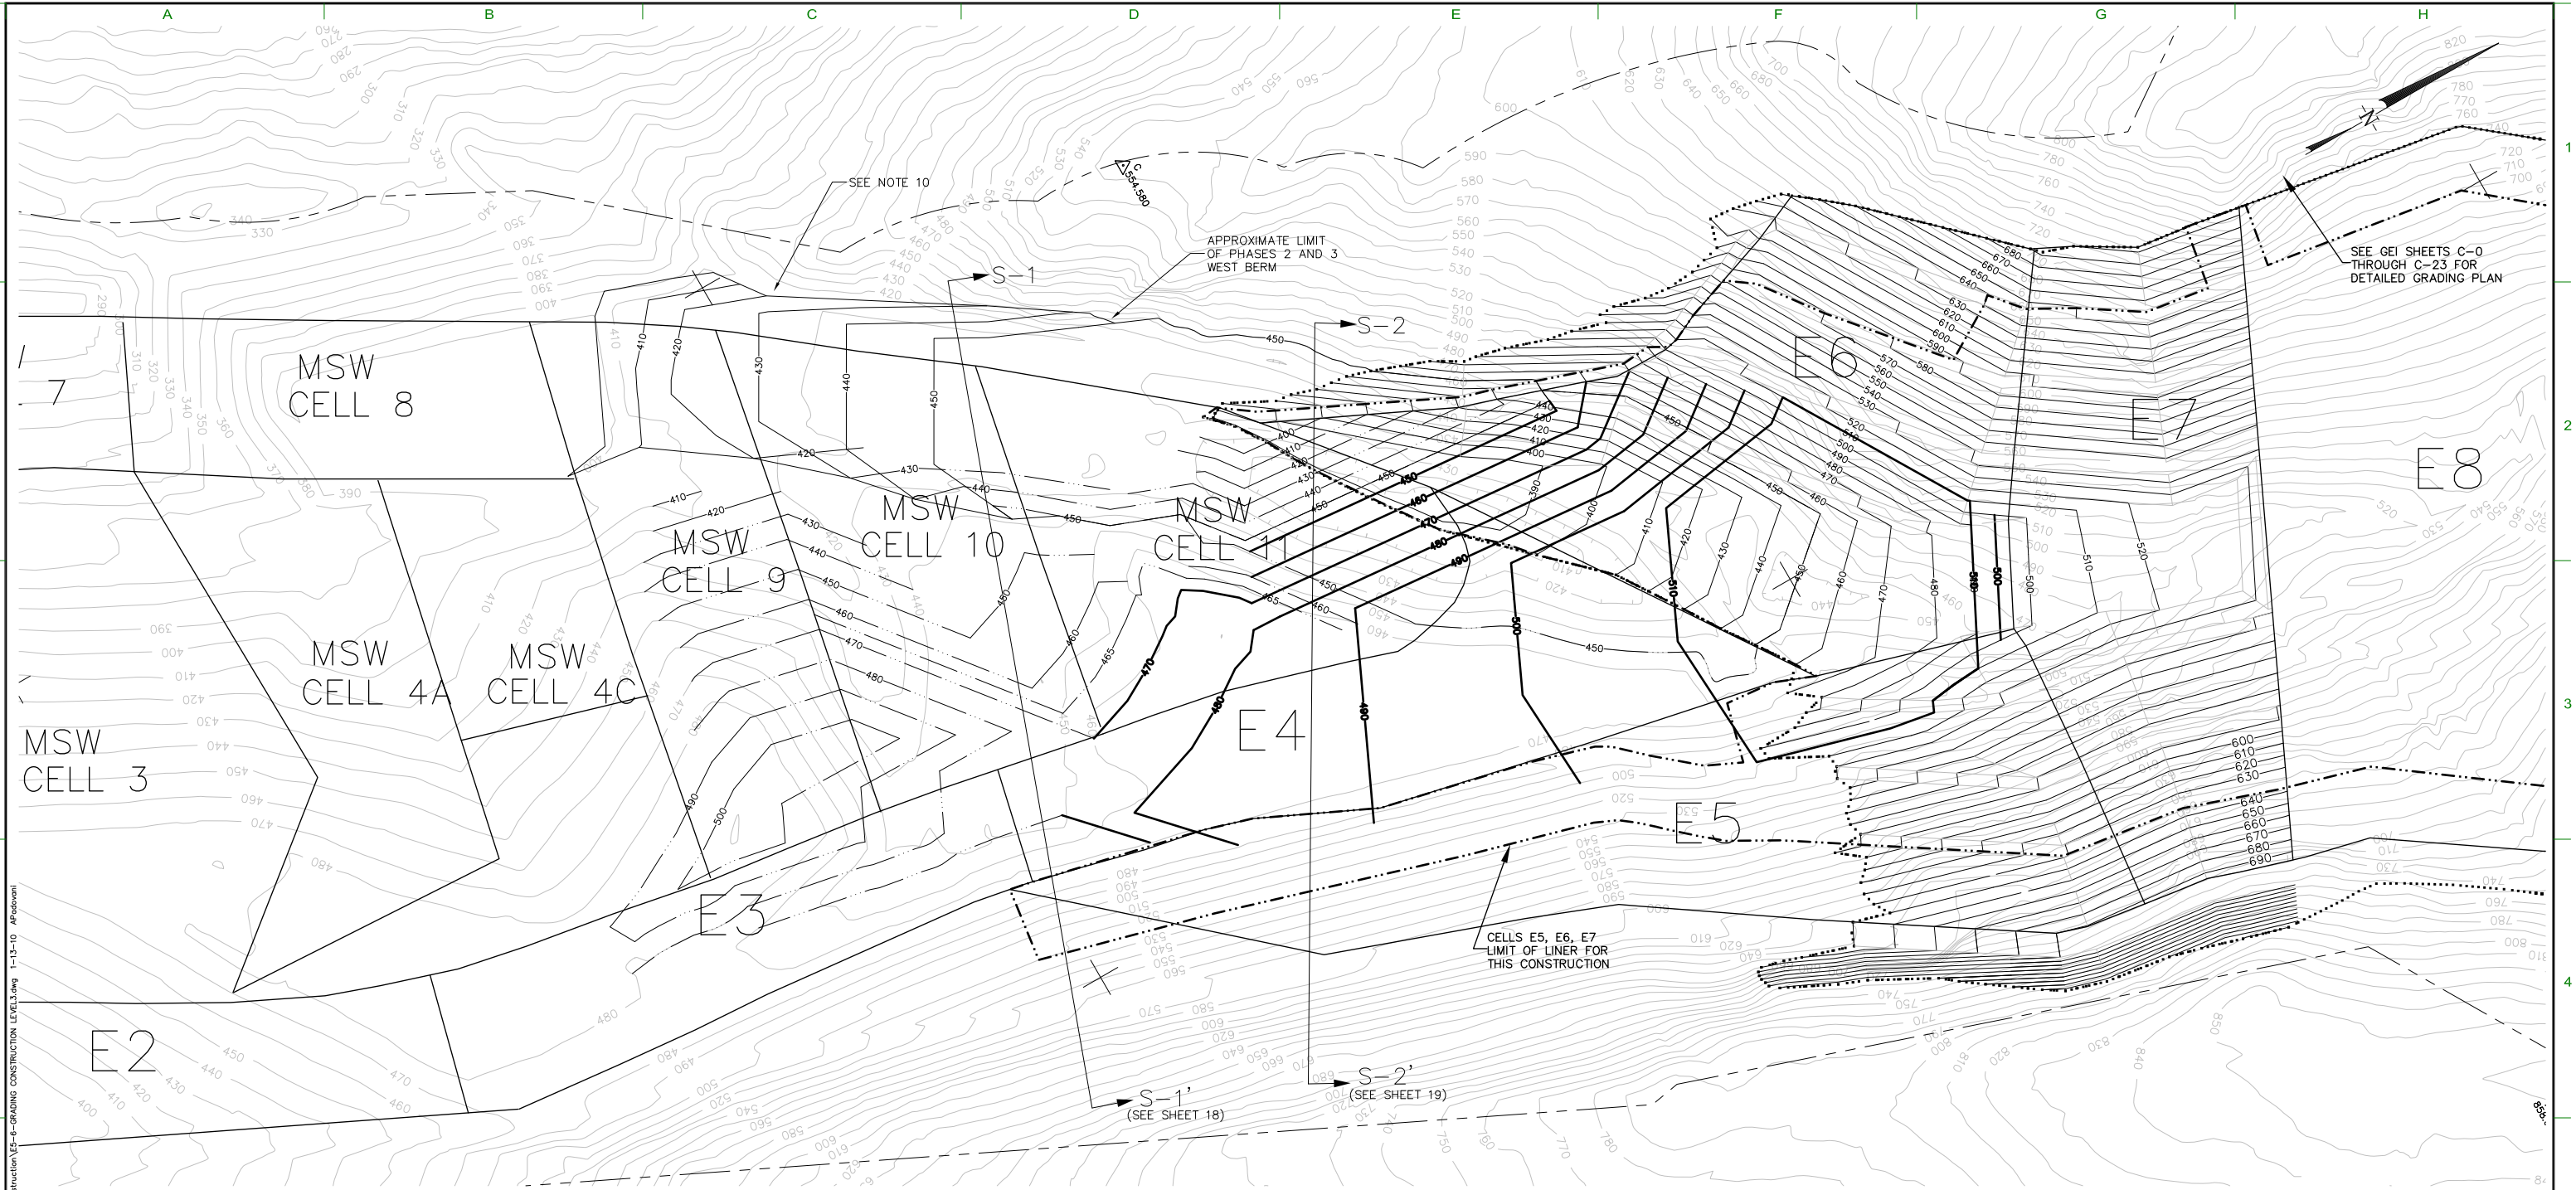

NOTES:


- EXISTING TOPOGRAPHY BASED ON 16 MARCH 2009 AERIAL SURVEY PROVIDED BY OWNER.
- THE LOCATION OF TIE-IN TO EXISTING LINER SHOWN IS APPROXIMATE. ACTUAL LOCATION OF TIE-IN SHOULD BE FIELD VERIFIED PRIOR TO CONSTRUCTION AND MAY VARY FROM LAYOUT SHOWN. CONTRACTOR TO FIELD LOCATE AND UNCOVER EXISTING LINER SYSTEM TERMINATION, AND EXTEND AND CONNECT NEW LINER SYSTEM COMPONENTS TO EXISTING AS NECESSARY TO MAINTAIN LINER SYSTEM CONTINUITY.
- GRADES ALONG TIE-IN MAY BE ADJUSTED AS NEEDED TO MATCH EXISTING SUBGRADE CONDITIONS WITH APPROVAL BY THE ENGINEER.
- FOR VEHICULAR TRAFFIC ON LINER SYSTEM, MINIMUM ALLOWABLE GROUND PRESSURES AND COVER MATERIAL REQUIREMENTS IN THE SPECIFICATIONS TO BE FOLLOWED AT ALL TIMES DURING AND AFTER CONSTRUCTION.
- BEFORE, DURING, AND AFTER STORM EVENTS, CONTRACTOR TO CONTROL AND DIRECT SURFACE WATER RUNOFF BY PUMPING OR OTHER METHODS. CONTRACTOR TO COORDINATE WITH OWNER FOR EROSION CONTROL METHODS.
- BENCHES THAT WILL NOT RECEIVE LINER SHALL BE LOCALLY GRADED SO THAT WATER FLOWS AWAY FROM LANDFILL.
- PLACE MSW FILL IN CELLS 11, E4, E5 AND E6, AFTER PHASE 3 WEST BERM HAS BEEN CONSTRUCTED, TO THE GRADES AND LIMITS SHOWN.
- A MINIMUM OF THREE DAYS BEFORE STARTING CONSTRUCTION AND AS PART OF MOBILIZATION, CONTRACTOR WITH OWNER/OPERATOR SHALL CLEARLY MARK/IDENTIFY THE LOCATION OF EXISTING UTILITIES AND/OR FACILITIES. EXISTING UTILITIES MAY BE OVERHEAD, ABOVE-

NOTES (CONT.):

- GROUND, OR BURIED. EXISTING UTILITIES INCLUDE, BUT ARE NOT LIMITED TO, OVERHEAD POWER LINES AND EXISTING FOUNDATIONS; GROUNDWATER MONITORING WELLS; LANDFILL GAS PROBES; LANDFILL GAS WELLS; SURFACE WATER SAMPLING LOCATIONS; LANDFILL GAS, LANDFILL CONDENSATE, AND LEACHATE PIPELINES, SURFACE CONTROL PIPES; ETC. COORDINATION WITH LOCAL UTILITIES AND/OR A PRIVATE UTILITY LOCATION SERVICE MAY BE REQUIRED.
- LOCATION OF EXISTING UTILITIES SHALL BE CLEARLY MARKED BY FLAGGED 4-FT HIGH WOODEN STAKES AT 100-FT INTERVALS AND PAINT ON THE GROUND SURFACE. NEARER INTERVALS MAY BE REQUIRED BASED ON FIELD CONDITIONS. CONTRACTOR SHALL MONITOR AND MAINTAIN THE MARKINGS DURING THE CONSTRUCTION PROJECT UNTIL FINAL ACCEPTANCE OF THE WORK BY THE OWNER/OPERATOR.
9. CONTRACTOR SHALL FOLLOW ALL APPLICABLE CITY, STATE AND FEDERAL HEALTH AND SAFETY REQUIREMENTS TO GUARD AND PROTECT ALL WORKERS, PEDESTRIANS, AND THE PUBLIC FROM EXCAVATIONS, BLASTING OPERATIONS, CONSTRUCTION EQUIPMENT, TRAFFIC, CONSTRUCTION OPERATIONS, ALL OBSTRUCTIONS, AND OTHER DANGEROUS ITEMS (E.G., LANDFILL GAS) OR AREAS. A HEALTH AND SAFETY PLAN IS REQUIRED AS PART OF THE WORK.
10. CONTRACTOR TO TIE WEST BERM FILL GRADES TO TOPOGRAPHY AND/OR WESTERN DRAINAGE SYSTEM'S RIGHT OF WAY AND PROVIDE AN AS-BUILT SURVEY FOR APPROVAL BY ENGINEER.
11. EXPECTED TO BE CONSTRUCTED BETWEEN 2010 AND 2014. CELL BOUNDARY AND/OR LIMIT OF FUTURE WASTE FILL IN CELLS E5 THROUGH E8 MAY CHANGE DEPENDING ON FUTURE WASTE STREAM.

LEGEND

- 500 STAGE 3 MSW GRADES 10-FT CONTOUR (MSL)
- 480 CELLS E5 THROUGH E7 BASE GRADE 10-FT CONTOUR (MSL)
- 800 EXISTING GROUND 10-FT CONTOUR (MSL)
- 440 EXISTING MSW GRADES
- 288.16 EXISTING BENCHMARK
- CELL BOUNDARY
- PROPERTY LINE
- APPROXIMATE LIMIT OF EARTHWORK
- APPROXIMATE CELLS E5 THROUGH E8 LINER LIMIT (NOTE 11)
- EXISTING WEST BERM GRADES
- CROSS SECTION LINE

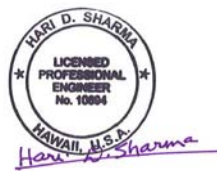

REVISIONS			
NO.	DESCRIPTION	DATE	BY




Geosyntec  
consultants

475 14th Street  
Suite 400  
Oakland, CA 94612


STAGE 3 MSW PLACEMENT  
ABOVE CELLS E5 AND E6  
CELLS E5 THROUGH E8  
WAIMANALO GULCH LANDFILL  
EWA BEACH, OAHU, HAWAII

CONSTRUCTION DRAWINGS  
DES BY: ACP DATE: JANUARY 2010  
DRN BY: ACP SCALE: AS SHOWN  
CHK BY: FWS PROJECT: WL0770  
REV BY: HDS  
APP BY: HDS DOCUMENT:  
FILE:


SHEET NO.  
16

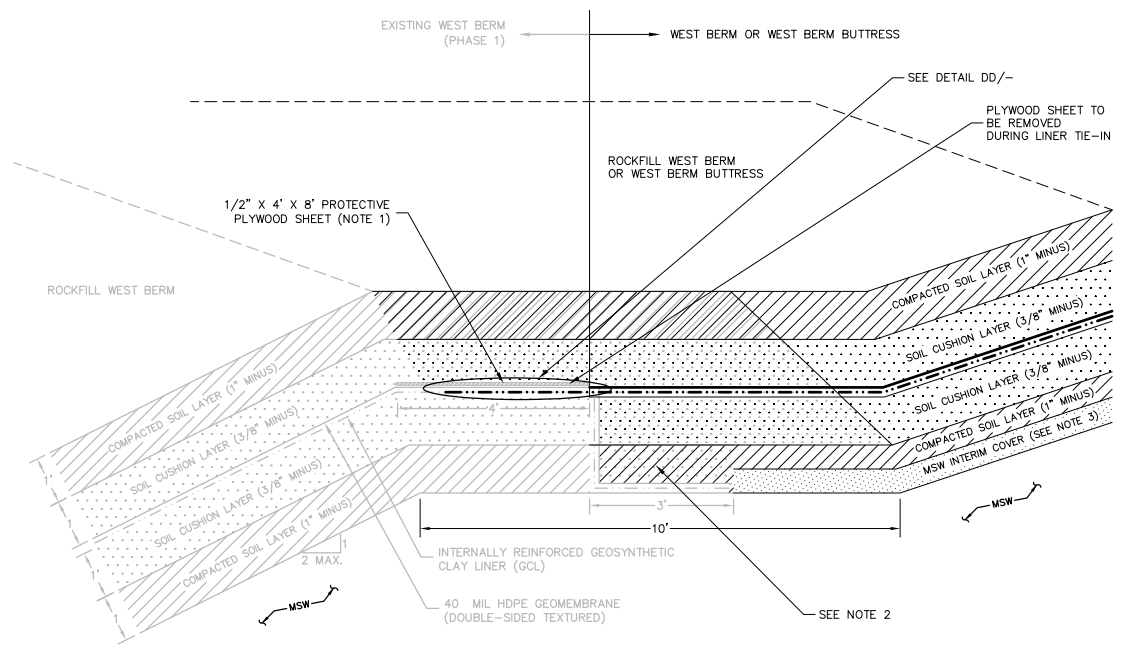


**CC 12/25**  
**DETAIL (TYPICAL)**  
**FINAL COVER LINER TIE-IN BELOW WEST BERM**  
(SEE NOTE 11)  
NOT TO SCALE

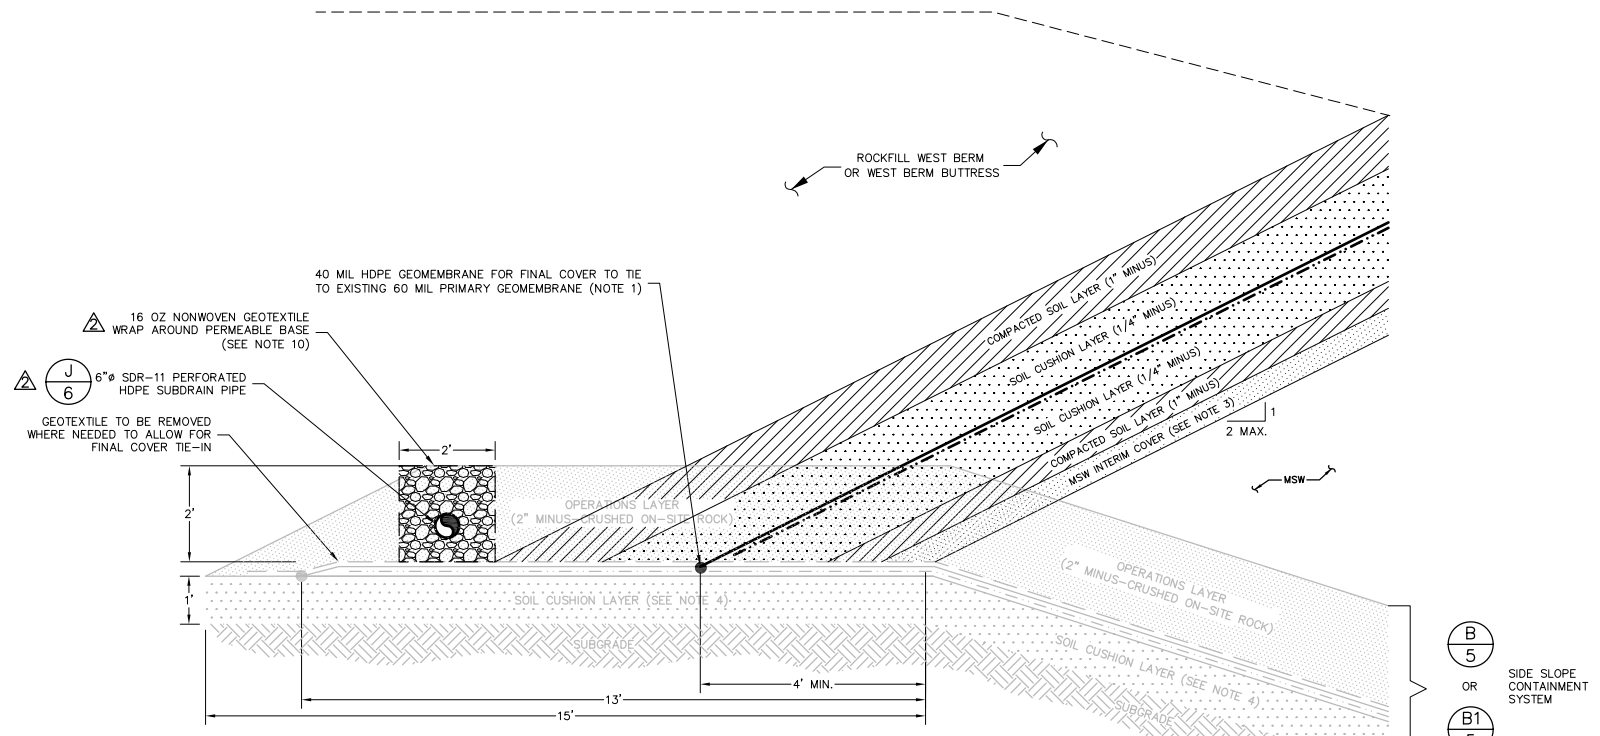


**EE 14/25**  
**DETAIL (TYPICAL)**  
**FINAL COVER LINER TIE-IN ALONG CELLS**  
**MSW 11, E6, AND PORTIONS OF MSW 3, 4A, 7, 8**  
(SEE NOTE 11)  
NOT TO SCALE

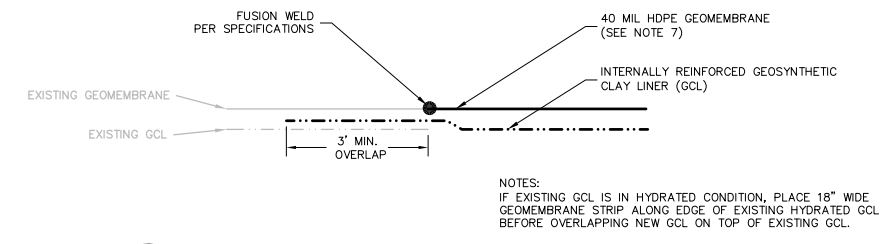

**DD**  
**DETAIL (TYPICAL)**  
**TIE-IN OVERLAP BELOW WEST BERM (NOTE 1)**  
NOT TO SCALE

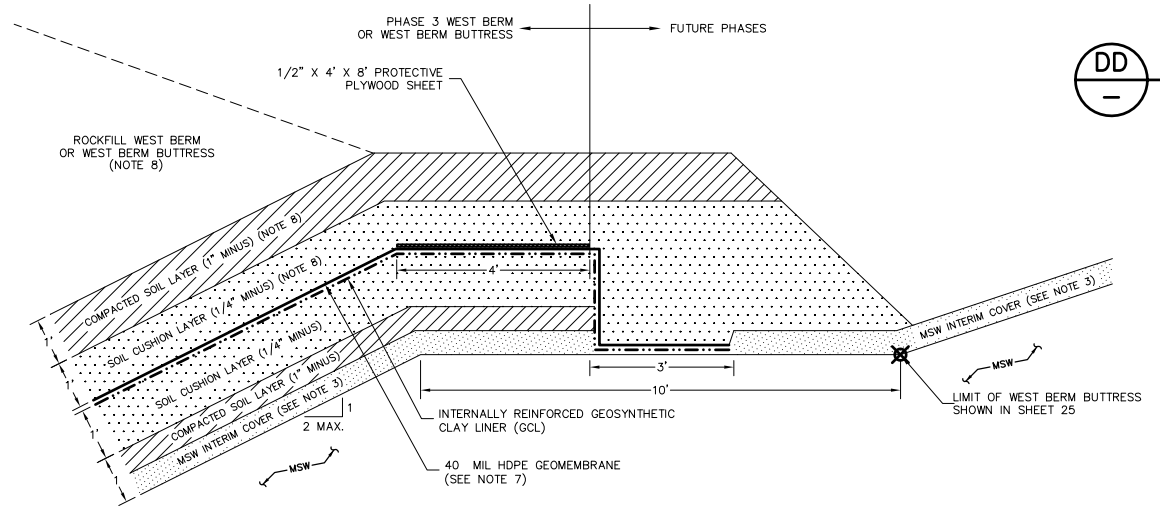

**GG 12/14/25**  
**DETAIL (TYPICAL)**  
**FINAL COVER LINER TERMINATION**  
**BELOW WEST BERM (NOTES 8 & 11)**  
NOT TO SCALE

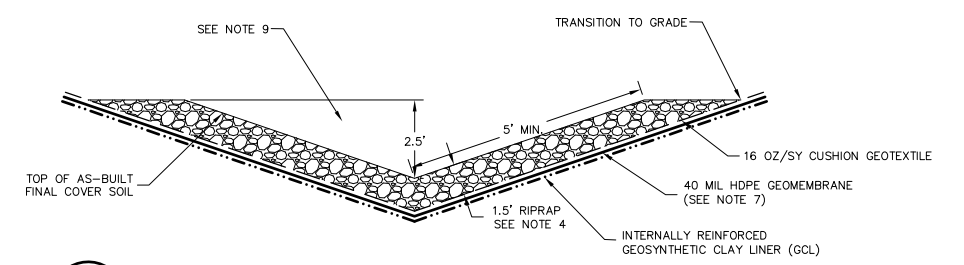

**FF 13/15/25**  
**DETAIL (TYPICAL)**  
**SURFACE WATER SWALE (NOTE 9)**  
NOT TO SCALE

- NOTES:
1. CONTRACTOR TO FIELD LOCATE AND UNCOVER EXISTING LINER SYSTEM AND FINAL COVER TERMINATIONS IN THE AREA OF WEST BERM. EXTEND AND CONNECT NEW FINAL COVER SYSTEM TO EXISTING CONTAINMENT SYSTEM OR FINAL COVER SYSTEM AS NECESSARY TO MAINTAIN A CONTINUOUS CONTAINMENT SYSTEM I.E., (A) WELD NEW GEOMEMBRANE TO EXISTING GEOMEMBRANE; AND (B) OVERLAP THE NEW GCL A MINIMUM OF 3 FT OVER THE EXISTING GCL.
  2. CONTRACTOR TO FIELD-VERIFY EXISTING LINER/FINAL COVER TERMINATIONS. IF CONDITIONS VARY, CHANGES TO DIMENSIONS MAY BE MADE UPON APPROVAL FROM THE ENGINEER.
  3. EXISTING INTERIM COVER ABOVE MSW MAY ACCOUNT FOR A PORTION OF THE COMPACTED SOIL LAYER THICKNESS PROVIDED THE INTERIM COVER MATERIAL MEETS REQUIREMENTS IN THE SPECIFICATIONS FOR COMPACTED SOIL (I.E., COMPACTION AND GRADATION).
  4. RIPRAP WITH A  $D_{50} = 12$  INCHES SHOULD BE PLACED TO 5 FEET OF EITHER SIDE OF THE SURFACE WATER SWALE AS PROTECTION AGAINST EROSION. HORIZONTAL EXTENT OF SURFACE WATER SWALE AS SHOWN ON **SHEETS 4 AND 25**.
  5. DURING CONSTRUCTION INSTALLER/CONTRACTOR MAY REQUIRE SAND BAGS TO ADDRESS WIND UPLIFT OF GEOSYNTHETICS.
  6. SCREENED BACK FEATURES CORRESPOND TO EXISTING OR FUTURE LAYERS.
  7. GEOMEMBRANES SHALL BE DOUBLE-SIDED TEXTURED.
  8. (i) STAGING OF PLACEMENT OF SOIL CUSHION, COMPACTED SOIL, AND ROCKFILL SHALL BE NECESSARY.  
(ii) CONTRACTOR SHALL ANCHOR THE GEOSYNTHETICS AND COMPLETE THE PLACEMENT OF OVERLYING COMPACTED SOIL AND CUSHION LAYERS ON THE BENCH PRIOR TO PLACEMENT OF OVERLYING SOIL CUSHION AND COMPACTED SOIL LAYERS ON THE SLOPE.  
(iii) CONTRACTOR SHALL PLACE SOIL CUSHION LAYER ABOVE GEOMEMBRANE A MAXIMUM LENGTH OF 15 FEET MEASURED ALONG THE SLOPE. CONTRACTOR SHALL USE A CATERPILLAR D3C LGP OR EQUIVALENT TO PLACE SOIL CUSHION WITHOUT BRAKING.  
(iv) CONTRACTOR SHALL PLACE COMPACTED SOIL LAYER AND ROCKFILL BERM TO BUTTRESS THE PREVIOUSLY PLACED SOIL CUSHION LAYER ABOVE THE GEOMEMBRANE.  
(v) COMPACTED SOIL LAYER AND WEST BERM MATERIAL SHALL ONLY BE COMPACTED IN HORIZONTAL LAYERS AND NOT BE COMPACTED UP AND DOWN THE SLOPE.
  9. CONTRACTOR TO BUILD SWALE TO DISCHARGE TO THE EXISTING SURFACE WATER SWALE AND/OR DITCH.
  10. BACKFILL MATERIAL TO BE AS DESCRIBED IN HDOT SECTION 703.4(A) AGGREGATE FOR UNTREATED PERMEABLE BASE, COARSE AGGREGATE MODIFIED SIZE 4 OR EQUIVALENT APPROVED BY THE ENGINEER.
  11. INTERFACE FRICTION TESTS SHALL BE CONDUCTED IN GENERAL ACCORDANCE WITH SECTION 02800 OF THE PROJECT SPECIFICATIONS.

HARI D. SHARMA  
LICENSED PROFESSIONAL ENGINEER  
No. 10894  
HAWAII, U.S.A.  
*Hari D. Sharma*

REVISIONS			
NO.	DESCRIPTION	DATE	BY
1	WEST BERM BUTTRESS ADDITION	11 MAR 10	
2	TESTING REQUIREMENTS	16 MAR 10	ACP




Geosyntec  
consultants

475 14th Street  
Suite 400  
Oakland, CA 94612

**WEST BERM FINAL COVER**  
**DETAILS I**  
  
CELLS E5 THROUGH E8  
WAIMANALO GULCH LANDFILL  
EWA BEACH, OAHU, HAWAII

CONSTRUCTION DRAWINGS			
DES BY: ACP	DATE: JANUARY 2010	SHEET NO.  17	
DRN BY: ACP	SCALE: AS SHOWN		
CHK BY: FWS	PROJECT: WL0770		
REV BY: HDS	DOCUMENT:		
APP BY: HDS	FILE:		



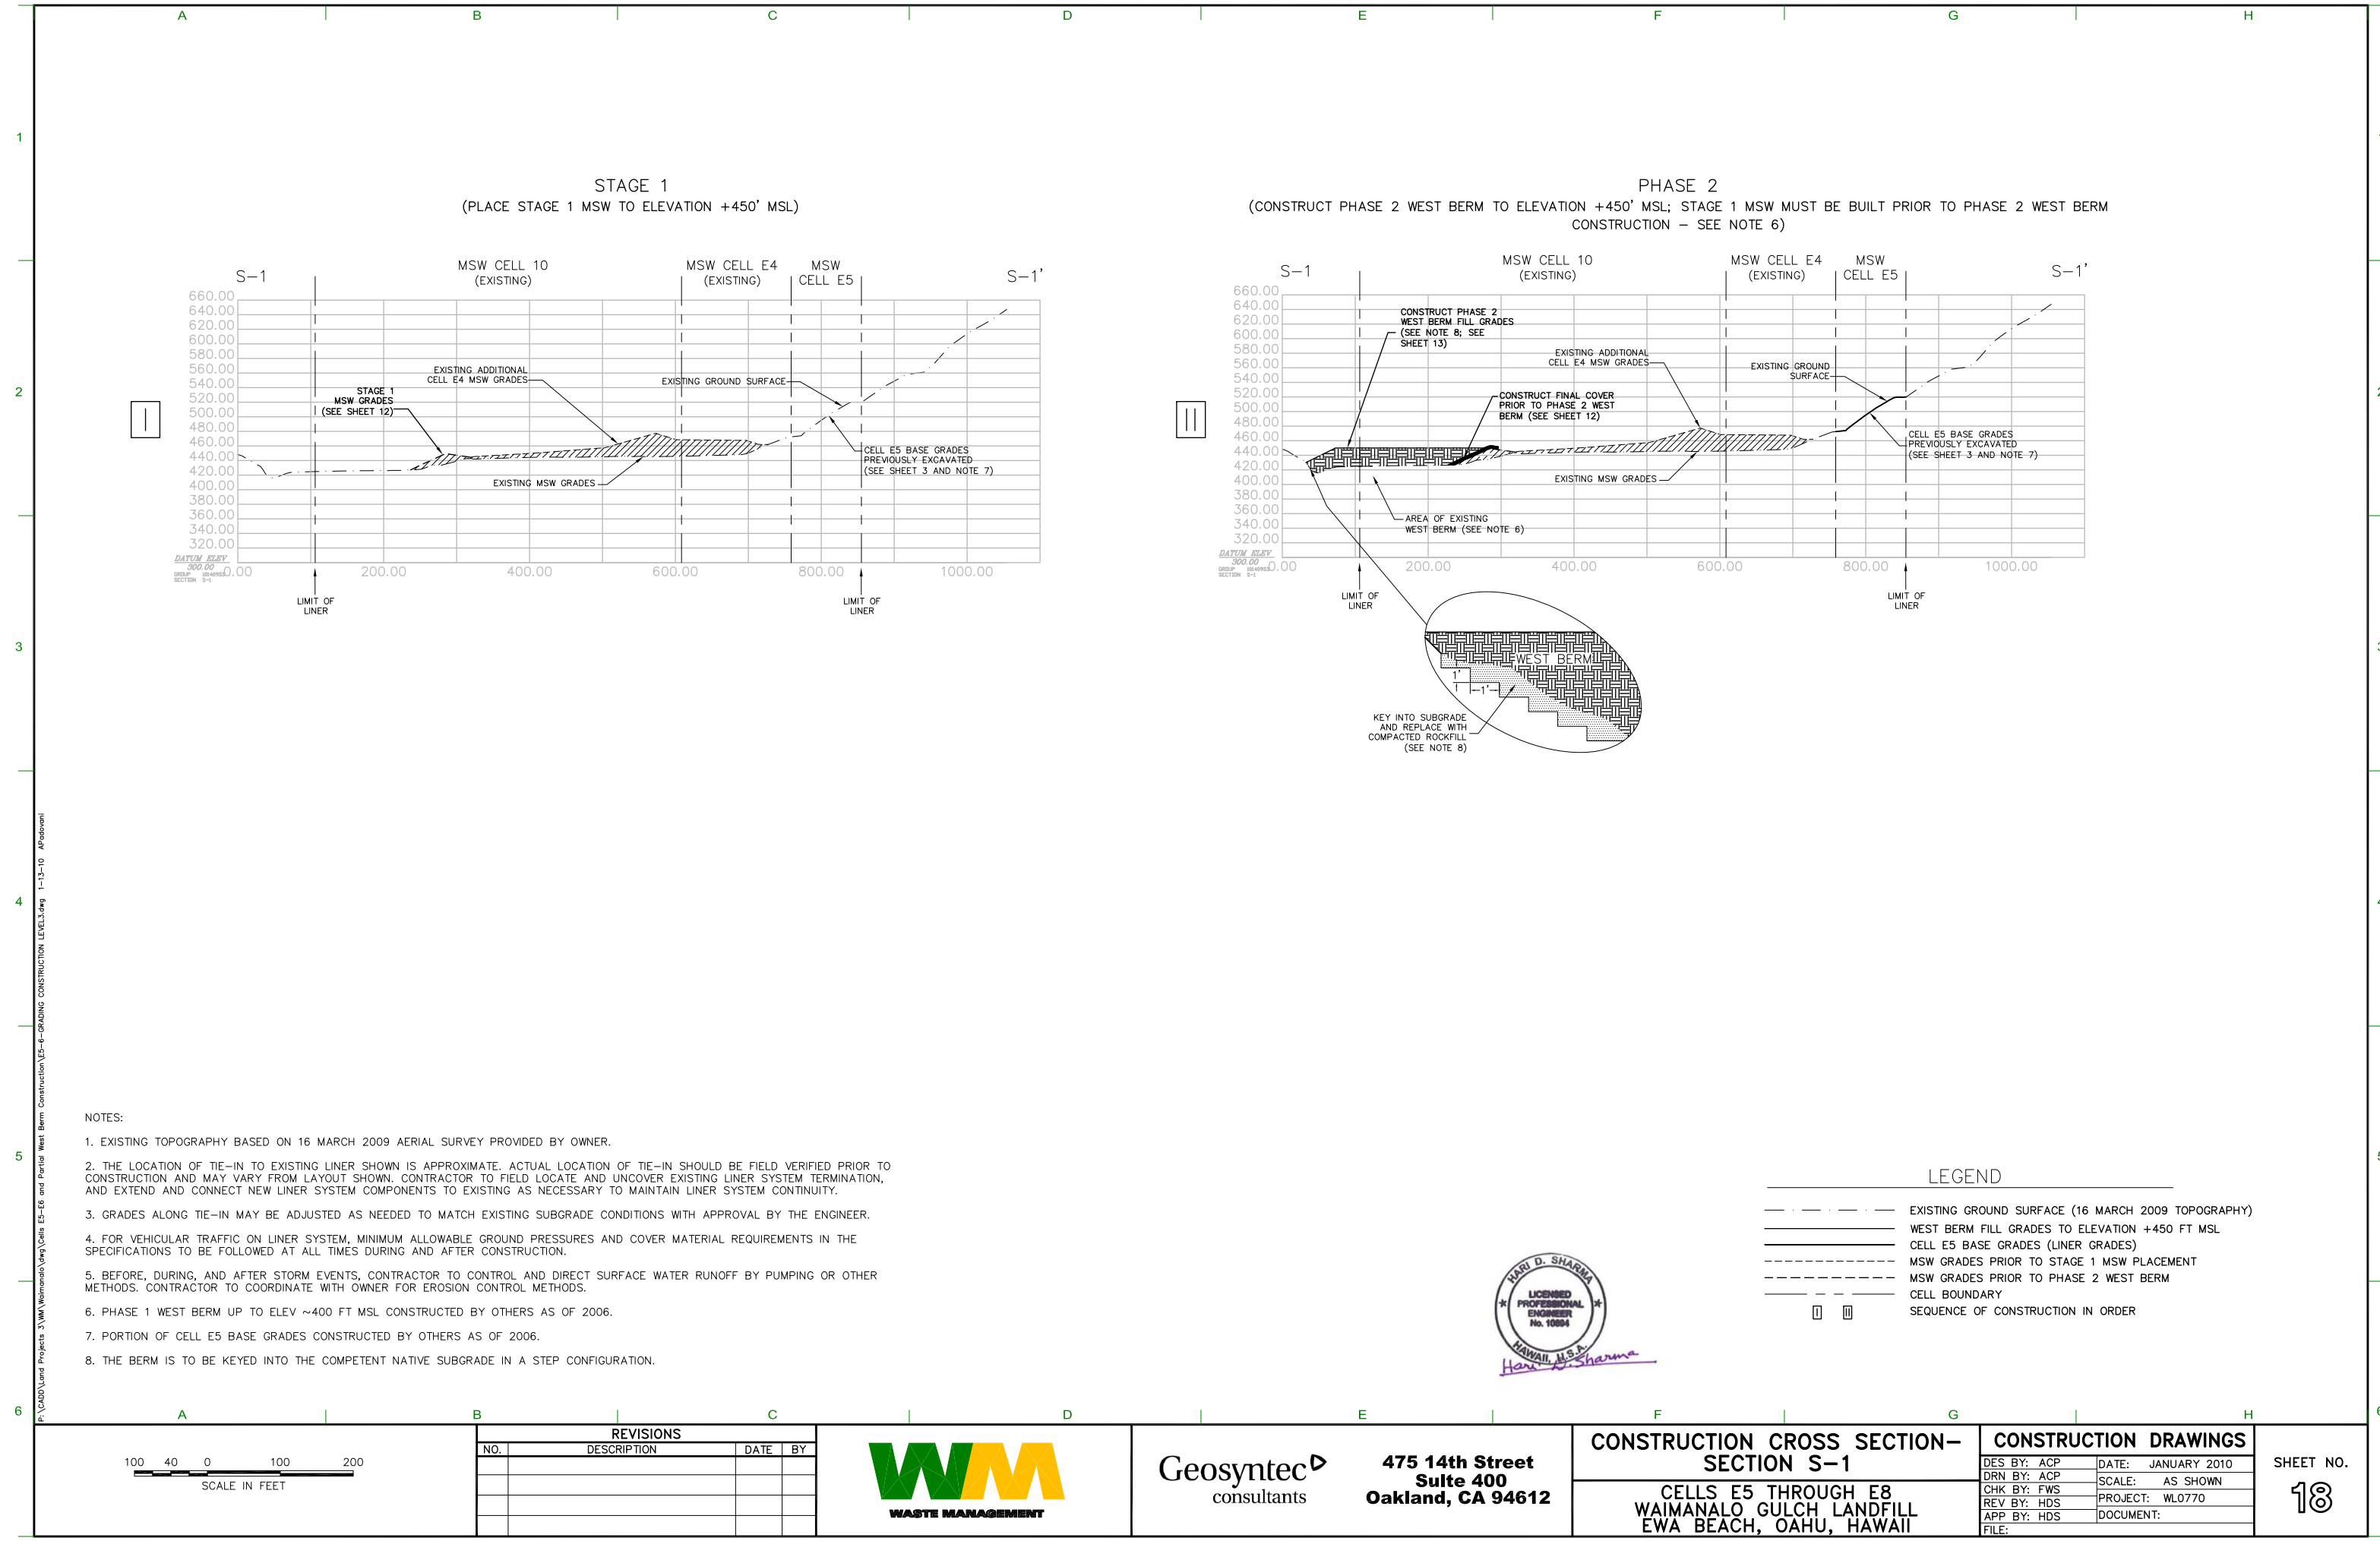


NOTES:

- EXISTING TOPOGRAPHY BASED ON 16 MARCH 2009 AERIAL SURVEY PROVIDED BY OWNER.
- THE LOCATION OF TIE-IN TO EXISTING LINER SHOWN IS APPROXIMATE. ACTUAL LOCATION OF TIE-IN SHOULD BE FIELD VERIFIED PRIOR TO CONSTRUCTION AND MAY VARY FROM LAYOUT SHOWN. CONTRACTOR TO FIELD LOCATE AND UNCOVER EXISTING LINER SYSTEM TERMINATION, AND EXTEND AND CONNECT NEW LINER SYSTEM COMPONENTS TO EXISTING AS NECESSARY TO MAINTAIN LINER SYSTEM CONTINUITY.
- GRADES ALONG TIE-IN MAY BE ADJUSTED AS NEEDED TO MATCH EXISTING SUBGRADE CONDITIONS WITH APPROVAL BY THE ENGINEER.
- FOR VEHICULAR TRAFFIC ON LINER SYSTEM, MINIMUM ALLOWABLE GROUND PRESSURES AND COVER MATERIAL REQUIREMENTS IN THE SPECIFICATIONS TO BE FOLLOWED AT ALL TIMES DURING AND AFTER CONSTRUCTION.
- BEFORE, DURING, AND AFTER STORM EVENTS, CONTRACTOR TO CONTROL AND DIRECT SURFACE WATER RUNOFF BY PUMPING OR OTHER METHODS. CONTRACTOR TO COORDINATE WITH OWNER FOR EROSION CONTROL METHODS.
- PHASE 1 WEST BERM UP TO ELEV ~400 FT MSL CONSTRUCTED BY OTHERS AS OF 2006.
- PORTION OF CELL E5 BASE GRADES CONSTRUCTED BY OTHERS AS OF 2006.
- THE BERM IS TO BE KEYED INTO THE COMPETENT NATIVE SUBGRADE IN A STEP CONFIGURATION.

LEGEND

- EXISTING GROUND SURFACE (16 MARCH 2009 TOPOGRAPHY)
- WEST BERM FILL GRADES TO ELEVATION +450 FT MSL
- CELL E5 BASE GRADES (LINER GRADES)
- MSW GRADES PRIOR TO STAGE 1 MSW PLACEMENT
- MSW GRADES PRIOR TO PHASE 2 WEST BERM
- CELL BOUNDARY
- SEQUENCE OF CONSTRUCTION IN ORDER

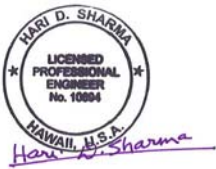

REVISIONS			
NO.	DESCRIPTION	DATE	BY



Geosyntec  
consultants

475 14th Street  
Suite 400  
Oakland, CA 94612

CONSTRUCTION CROSS SECTION—  
SECTION S-1

CELLS E5 THROUGH E8  
WAIMANALO GULCH LANDFILL  
EWA BEACH, OAHU, HAWAII

CONSTRUCTION DRAWINGS

DES BY: ACP	DATE: JANUARY 2010
DRN BY: ACP	SCALE: AS SHOWN
CHK BY: FWS	PROJECT: WL0770
REV BY: HDS	DOCUMENT:
APP BY: HDS	FILE:


SHEET NO.

18




P:\CAD\Land Projects\3\WMA\Waimanalo\Gulch Cells E5-E6 and Partial West Berm Construction\E5-E6-Grading Construction\LEVEL3.dwg 1-13-10 (R:\down)

EXCAVATION  
(EXCAVATE MSW CELL E6 BASE GRADES TO THE ELEVATIONS SHOWN ON SHEET 3)

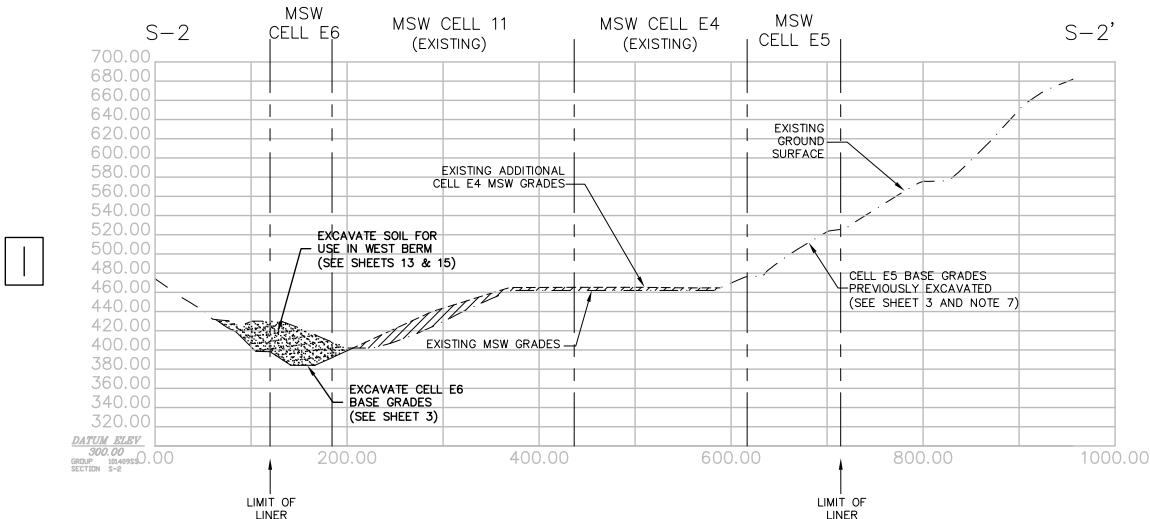

PHASE 3  
(STAGE 2 MSW MUST BE BUILT PRIOR TO PHASE 3 WEST BERM CONSTRUCTION)

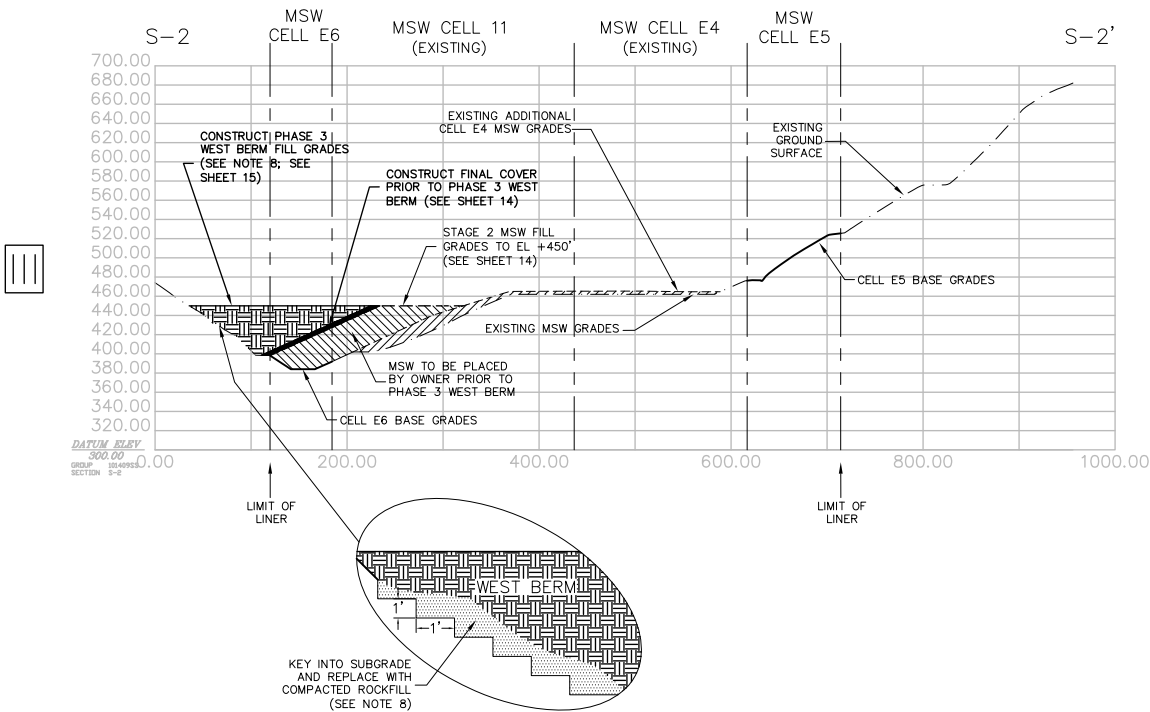

- NOTES:
- EXISTING TOPOGRAPHY BASED ON 16 MARCH 2009 AERIAL SURVEY PROVIDED BY OWNER.
  - THE LOCATION OF TIE-IN TO EXISTING LINER SHOWN IS APPROXIMATE. ACTUAL LOCATION OF TIE-IN SHOULD BE FIELD VERIFIED PRIOR TO CONSTRUCTION AND MAY VARY FROM LAYOUT SHOWN. CONTRACTOR TO FIELD LOCATE AND UNCOVER EXISTING LINER SYSTEM TERMINATION, AND EXTEND AND CONNECT NEW LINER SYSTEM COMPONENTS TO EXISTING AS NECESSARY TO MAINTAIN LINER SYSTEM CONTINUITY.
  - GRADES ALONG TIE-IN MAY BE ADJUSTED AS NEEDED TO MATCH EXISTING SUBGRADE CONDITIONS WITH APPROVAL BY THE ENGINEER.
  - FOR VEHICULAR TRAFFIC ON LINER SYSTEM, MINIMUM ALLOWABLE GROUND PRESSURES AND COVER MATERIAL REQUIREMENTS IN THE SPECIFICATIONS TO BE FOLLOWED AT ALL TIMES DURING AND AFTER CONSTRUCTION.
  - BEFORE, DURING, AND AFTER STORM EVENTS, CONTRACTOR TO CONTROL AND DIRECT SURFACE WATER RUNOFF BY PUMPING OR OTHER METHODS. CONTRACTOR TO COORDINATE WITH OWNER FOR EROSION CONTROL METHODS.
  - PHASE 1 WEST BERM UP TO ELEV ~400 FT MSL CONSTRUCTED BY OTHERS AS OF 2006.
  - PORTION OF CELL E5 BASE GRADES CONSTRUCTED BY OTHERS AS OF 2006.
  - THE BERM IS TO BE KEYED INTO THE COMPETENT NATIVE SUBGRADE IN A STEP CONFIGURATION.



REVISIONS			
NO.	DESCRIPTION	DATE	BY



Geosyntec  
consultants

475 14th Street  
Suite 400  
Oakland, CA 94612

CONSTRUCTION CROSS SECTION—  
SECTION S-2

CELLS E5 THROUGH E8  
WAIMANALO GULCH LANDFILL  
EWA BEACH, OAHU, HAWAII


CONSTRUCTION DRAWINGS

DES BY: ACP	DATE: JANUARY 2010
DRN BY: ACP	SCALE: AS SHOWN
CHK BY: FWS	PROJECT: WL0770
REV BY: HDS	DOCUMENT:
APP BY: HDS	FILE:


SHEET NO.

19

STAGE 2  
(STAGE 2 MSW CANNOT BE PLACED UNTIL EXCAVATION FOR CELL E6 HAS BEEN COMPLETED)

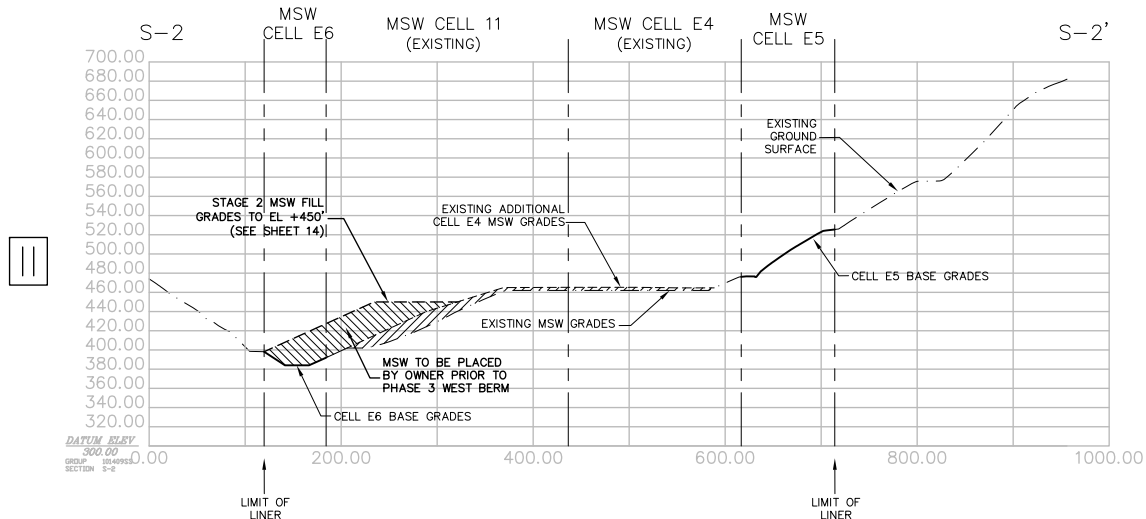


STAGE 3  
(STAGE 3 MSW CANNOT BE PLACED UNTIL PHASE 3 WEST BERM HAS BEEN CONSTRUCTED TO ELEVATION GRADES SHOWN ON SHEET 15)

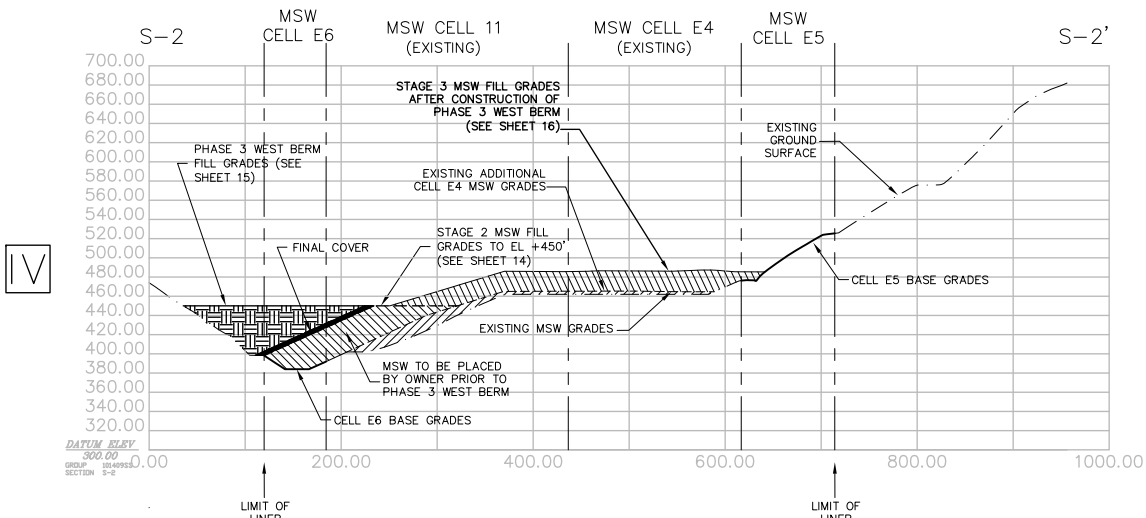


LEGEND


- EXISTING GROUND SURFACE (16 MARCH 2009 TOPOGRAPHY)
- WEST BERM FILL GRADES TO ELEVATION +450 FT MSL
- CELLS E5 AND E6 BASE GRADES (LINER GRADES)
- MSW GRADES PRIOR TO STAGE 2 MSW PLACEMENT
- MSW GRADES PRIOR TO PHASE 3 WEST BERM
- STAGE 3 MSW FILL GRADES
- CELL BOUNDARY
- SEQUENCE OF CONSTRUCTION IN ORDER

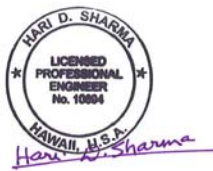



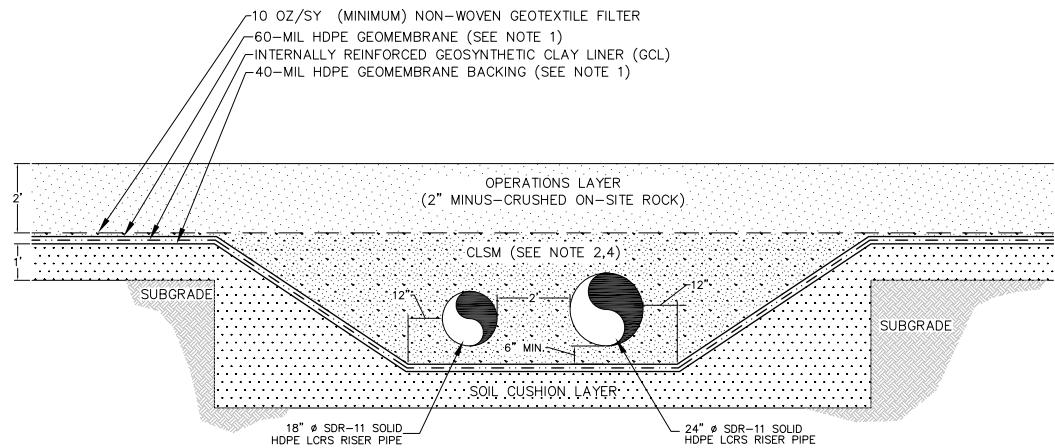


00  
4  
DETAIL (TYPICAL)  
E8 RISER TRENCH  
NOT TO SCALE

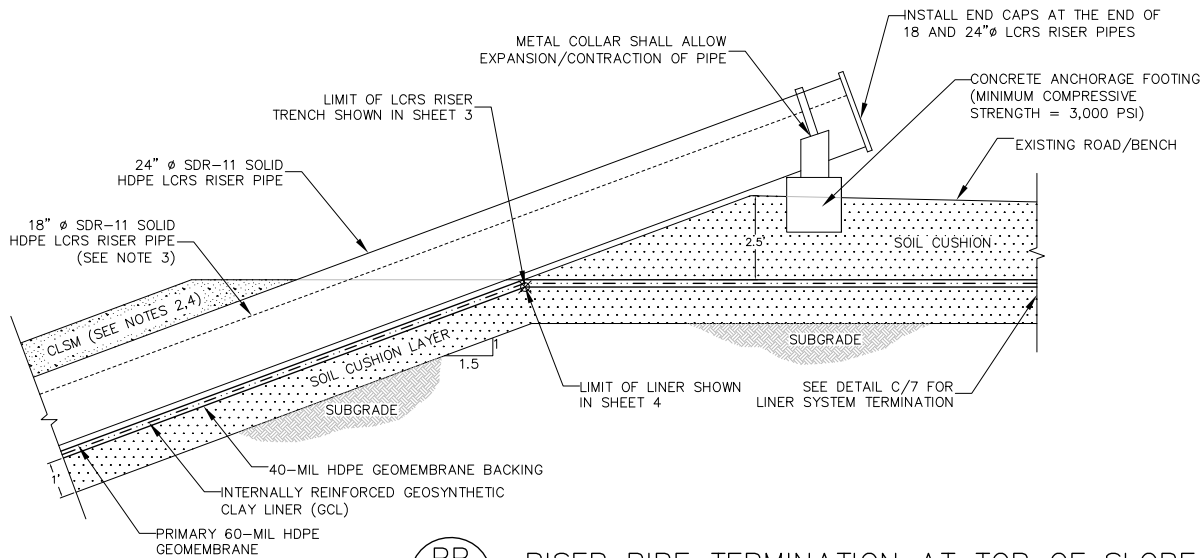

PP  
3/4  
RISER PIPE TERMINATION AT TOP OF SLOPE  
FOR CELLS E6 & E8  
NOT TO SCALE

NOTES:

1. FOR ALL CELLS, GEOMEMBRANE SHALL BE TEXTURED ON BOTH SIDES.
2. CLSM TO BE USED FOR CELL E8 LCRS RISER PIPE TRENCH SHALL HAVE A MAXIMUM PARTICLE SIZE FOR THE AGGREGATE OF  $\frac{1}{2}$ ".
3. LCRS RISER PIPE IS ALSO GAS EXTRACTION PIPE FOR E6 RISER.
4. CLSM SHALL BE PLACED IN STAGES TO MAINTAIN RISER TRENCH STABILITY.

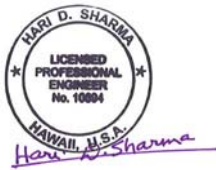

REVISIONS			
NO.	DESCRIPTION	DATE	BY



Geosyntec<sup>®</sup>  
consultants  
475 14th Street  
Suite 400  
Oakland, CA 94612

CONTAINMENT SYSTEM  
DETAILS VIII

CELLS E5 THROUGH E8  
WAIMANALO GULCH LANDFILL  
EWA BEACH, OAHU, HAWAII



CONSTRUCTION DRAWINGS

DES BY: ACP	DATE: JANUARY 2010
DRN BY: ACP	SCALE: AS SHOWN
CHK BY: FWS	PROJECT: WL0770
REV BY: HDS	DOCUMENT:
APP BY: HDS	FILE:

SHEET NO.

20



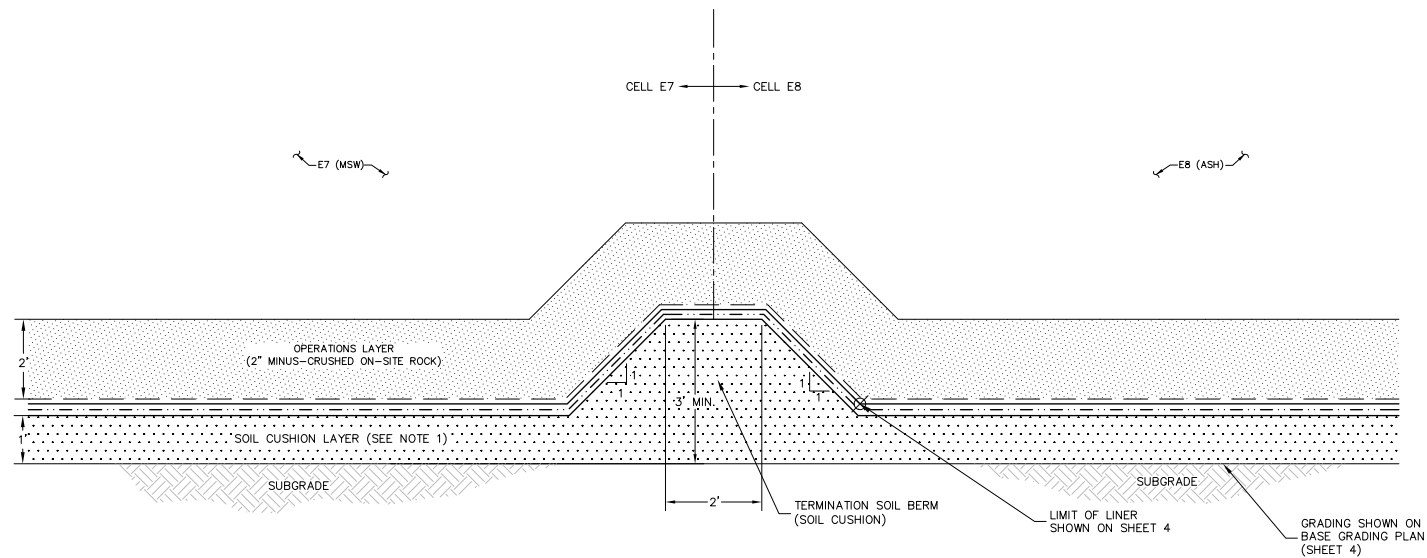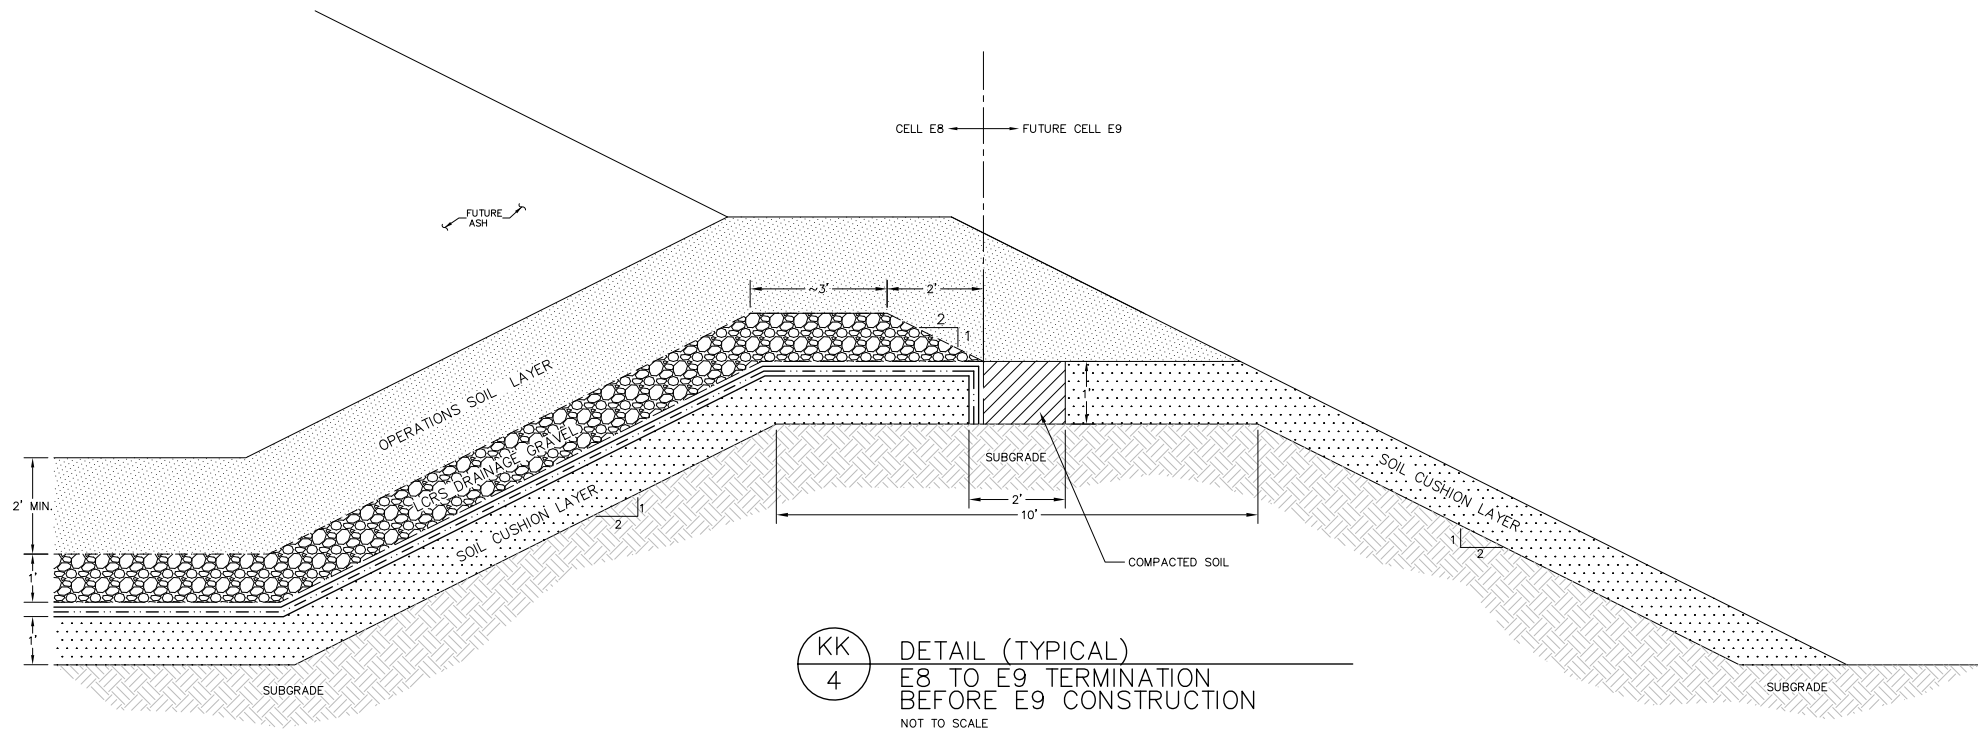

- NOTES:
1. IF SOIL CUSHION LAYER CAN NOT BE PLACED ON THE SIDE SLOPES, THEN THE SUBGRADE SHALL RECEIVE GUNITE HAVING SURFACE PROJECTIONS LESS THAN 0.25 INCH TO RECEIVE GEOSYNTHETICS.
  2. ASSUMES CELLS E7 AND E8 ARE CONSTRUCTED CONCURRENTLY.



REVISIONS			
NO.	DESCRIPTION	DATE	BY



Geosyntec  
consultants

475 14th Street  
Suite 400  
Oakland, CA 94612

## CONTAINMENT SYSTEM DETAILS IX




CELLS E5 THROUGH E8  
WAIMANALO GULCH LANDFILL  
EWA BEACH, OAHU, HAWAII

## CONSTRUCTION DRAWINGS

DES BY: ACP	DATE: JANUARY 2010
DRN BY: ACP	SCALE: AS SHOWN
CHK BY: FWS	PROJECT: WL0770
REV BY: HDS	DOCUMENT:
APP BY: HDS	FILE:

SHEET NO.

21

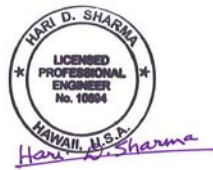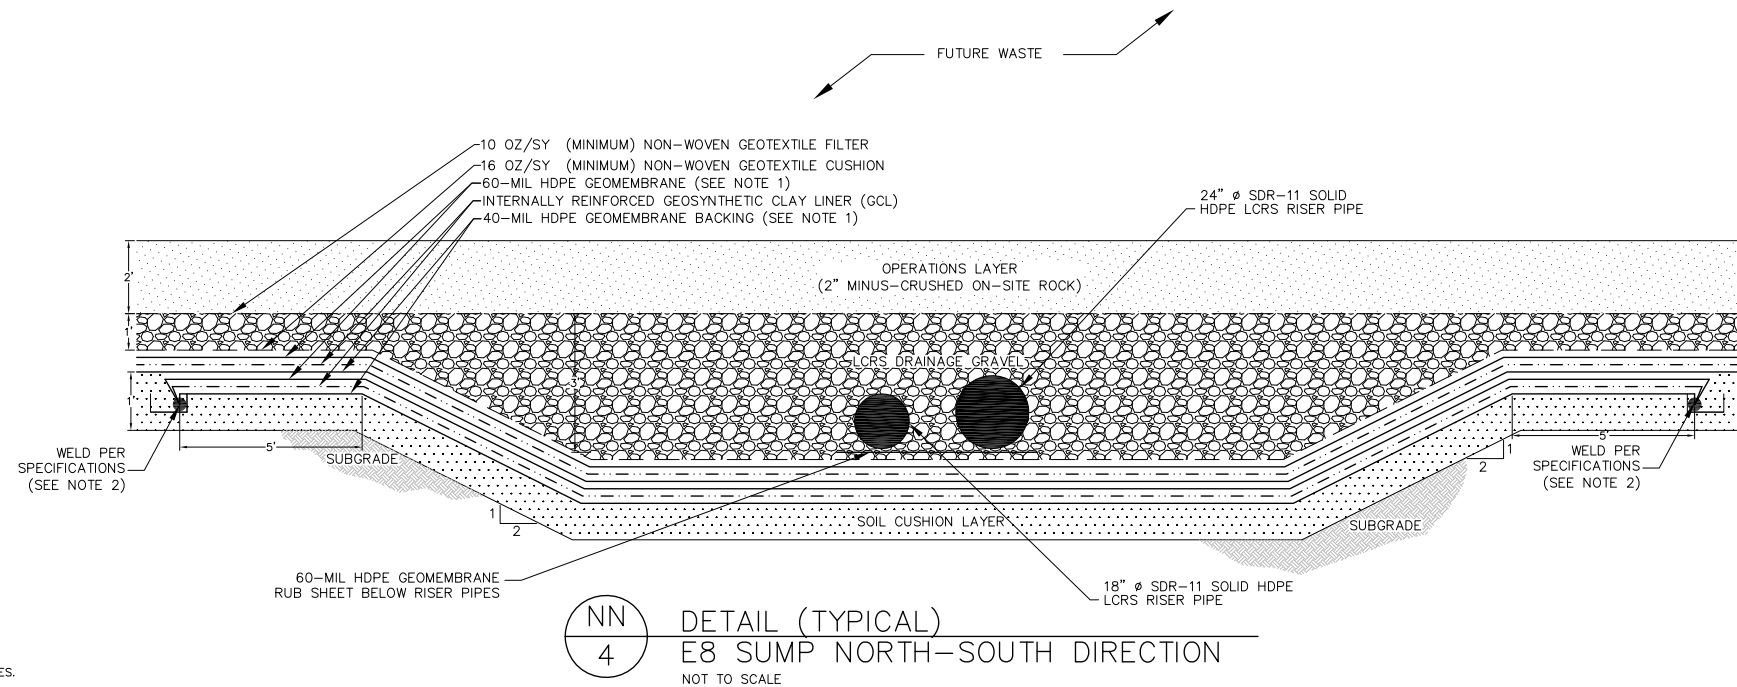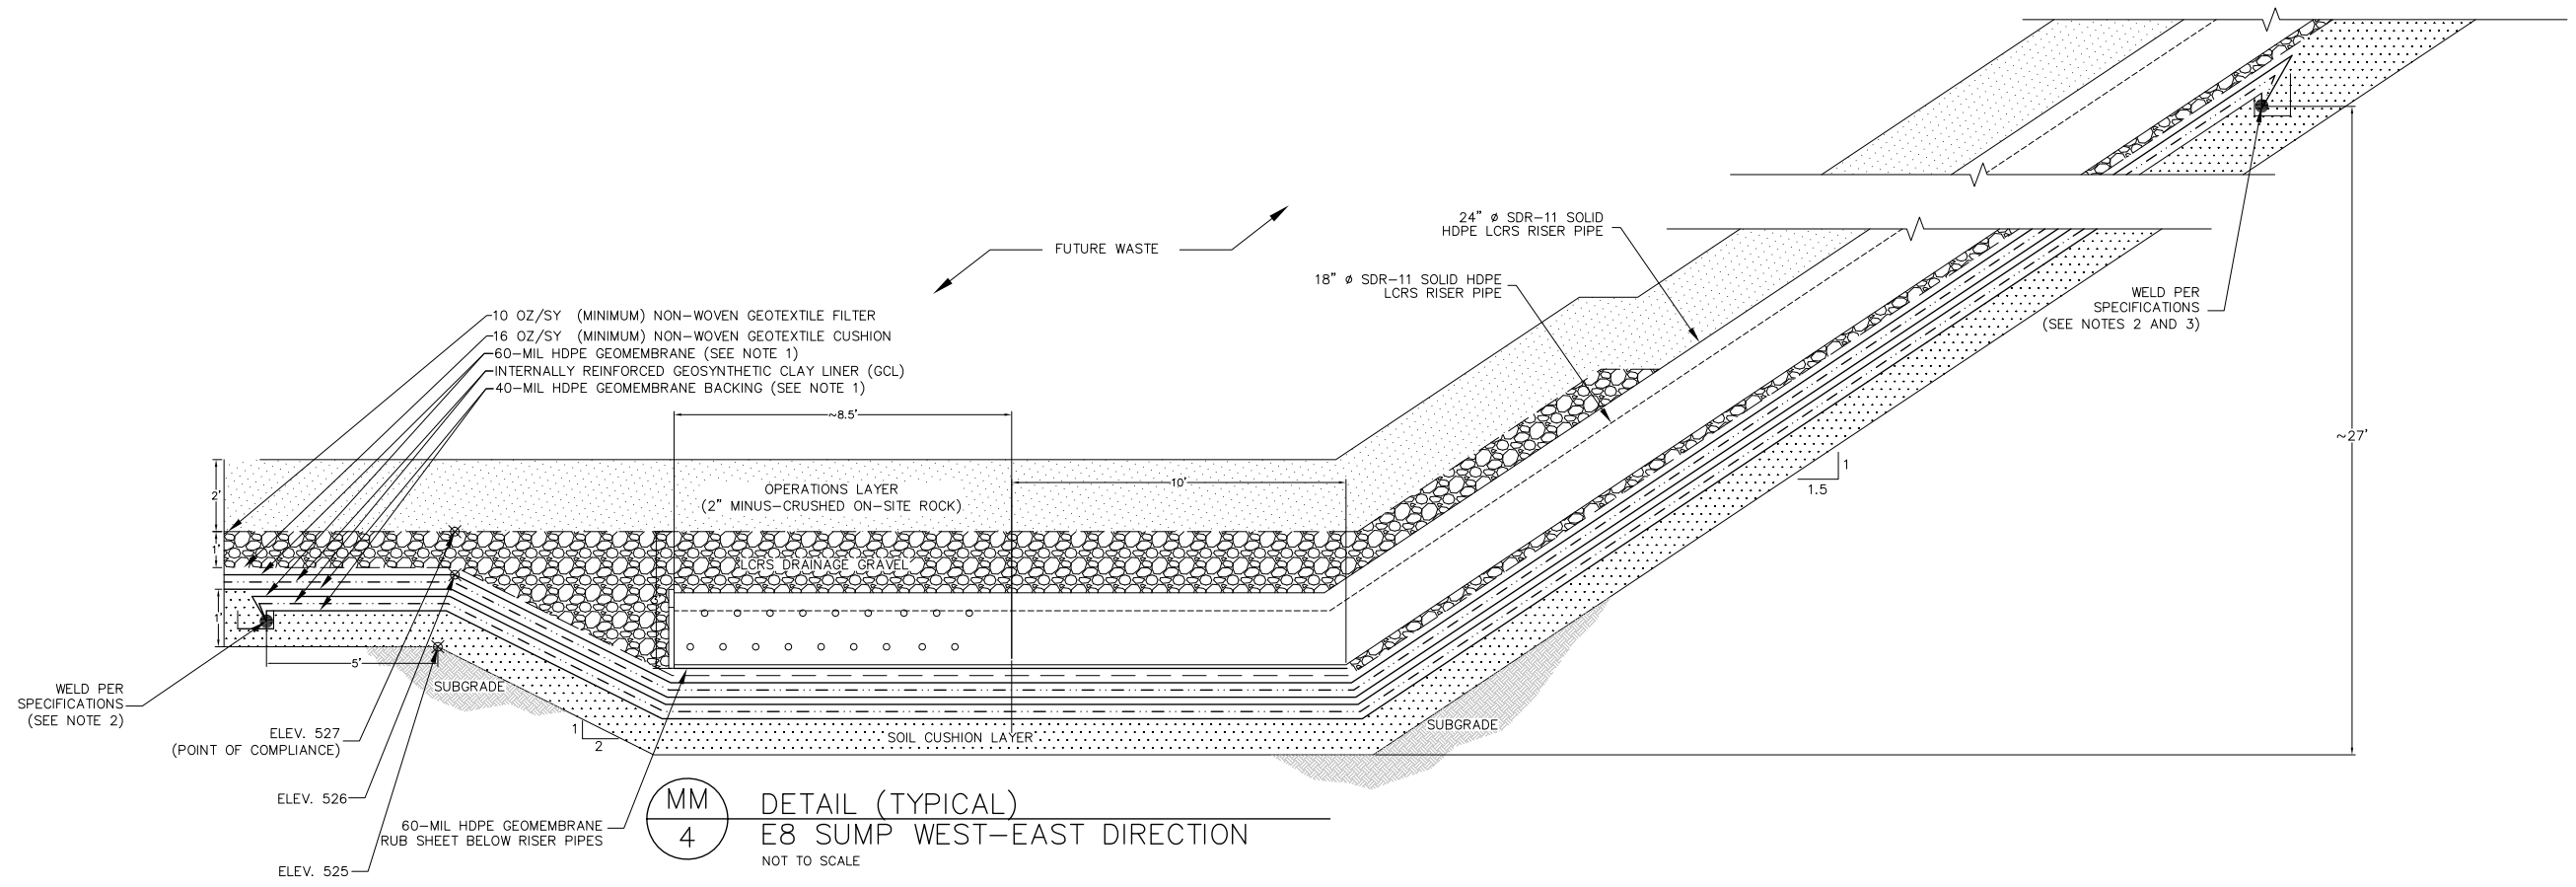

- NOTES:
1. FOR ALL CELLS, GEOMEMBRANE SHALL BE TEXTURED ON BOTH SIDES.
  2. INSERT SECONDARY ENCAPSULATED LINER SYSTEM INTO 6" DEEP TERMINATION TRENCH AND BACKFILL WITH COMPACTED SOIL CUSHION.
  3. EXTEND DOUBLE-LINER SYSTEM FROM SUMP TO BENCH AT ELEVATION 549 FT APPROXIMATELY.
  4. PIPE MATERIAL SHALL BE HDPE OR FRP.

REVISIONS			
NO.	DESCRIPTION	DATE	BY



Geosyntec  
 consultants

475 14th Street  
 Suite 400  
 Oakland, CA 94612


CONTAINMENT SYSTEM  
 DETAILS X

CELLS E5 THROUGH E8  
 WAIMANALO GULCH LANDFILL  
 EWA BEACH, OAHU, HAWAII

CONSTRUCTION DRAWINGS	
DES BY: ACP	DATE: JANUARY 2010
DRN BY: ACP	SCALE: AS SHOWN
CHK BY: FWS	PROJECT: WL0770
REV BY: HDS	DOCUMENT:
APP BY: HDS	FILE:

SHEET NO.  
 22



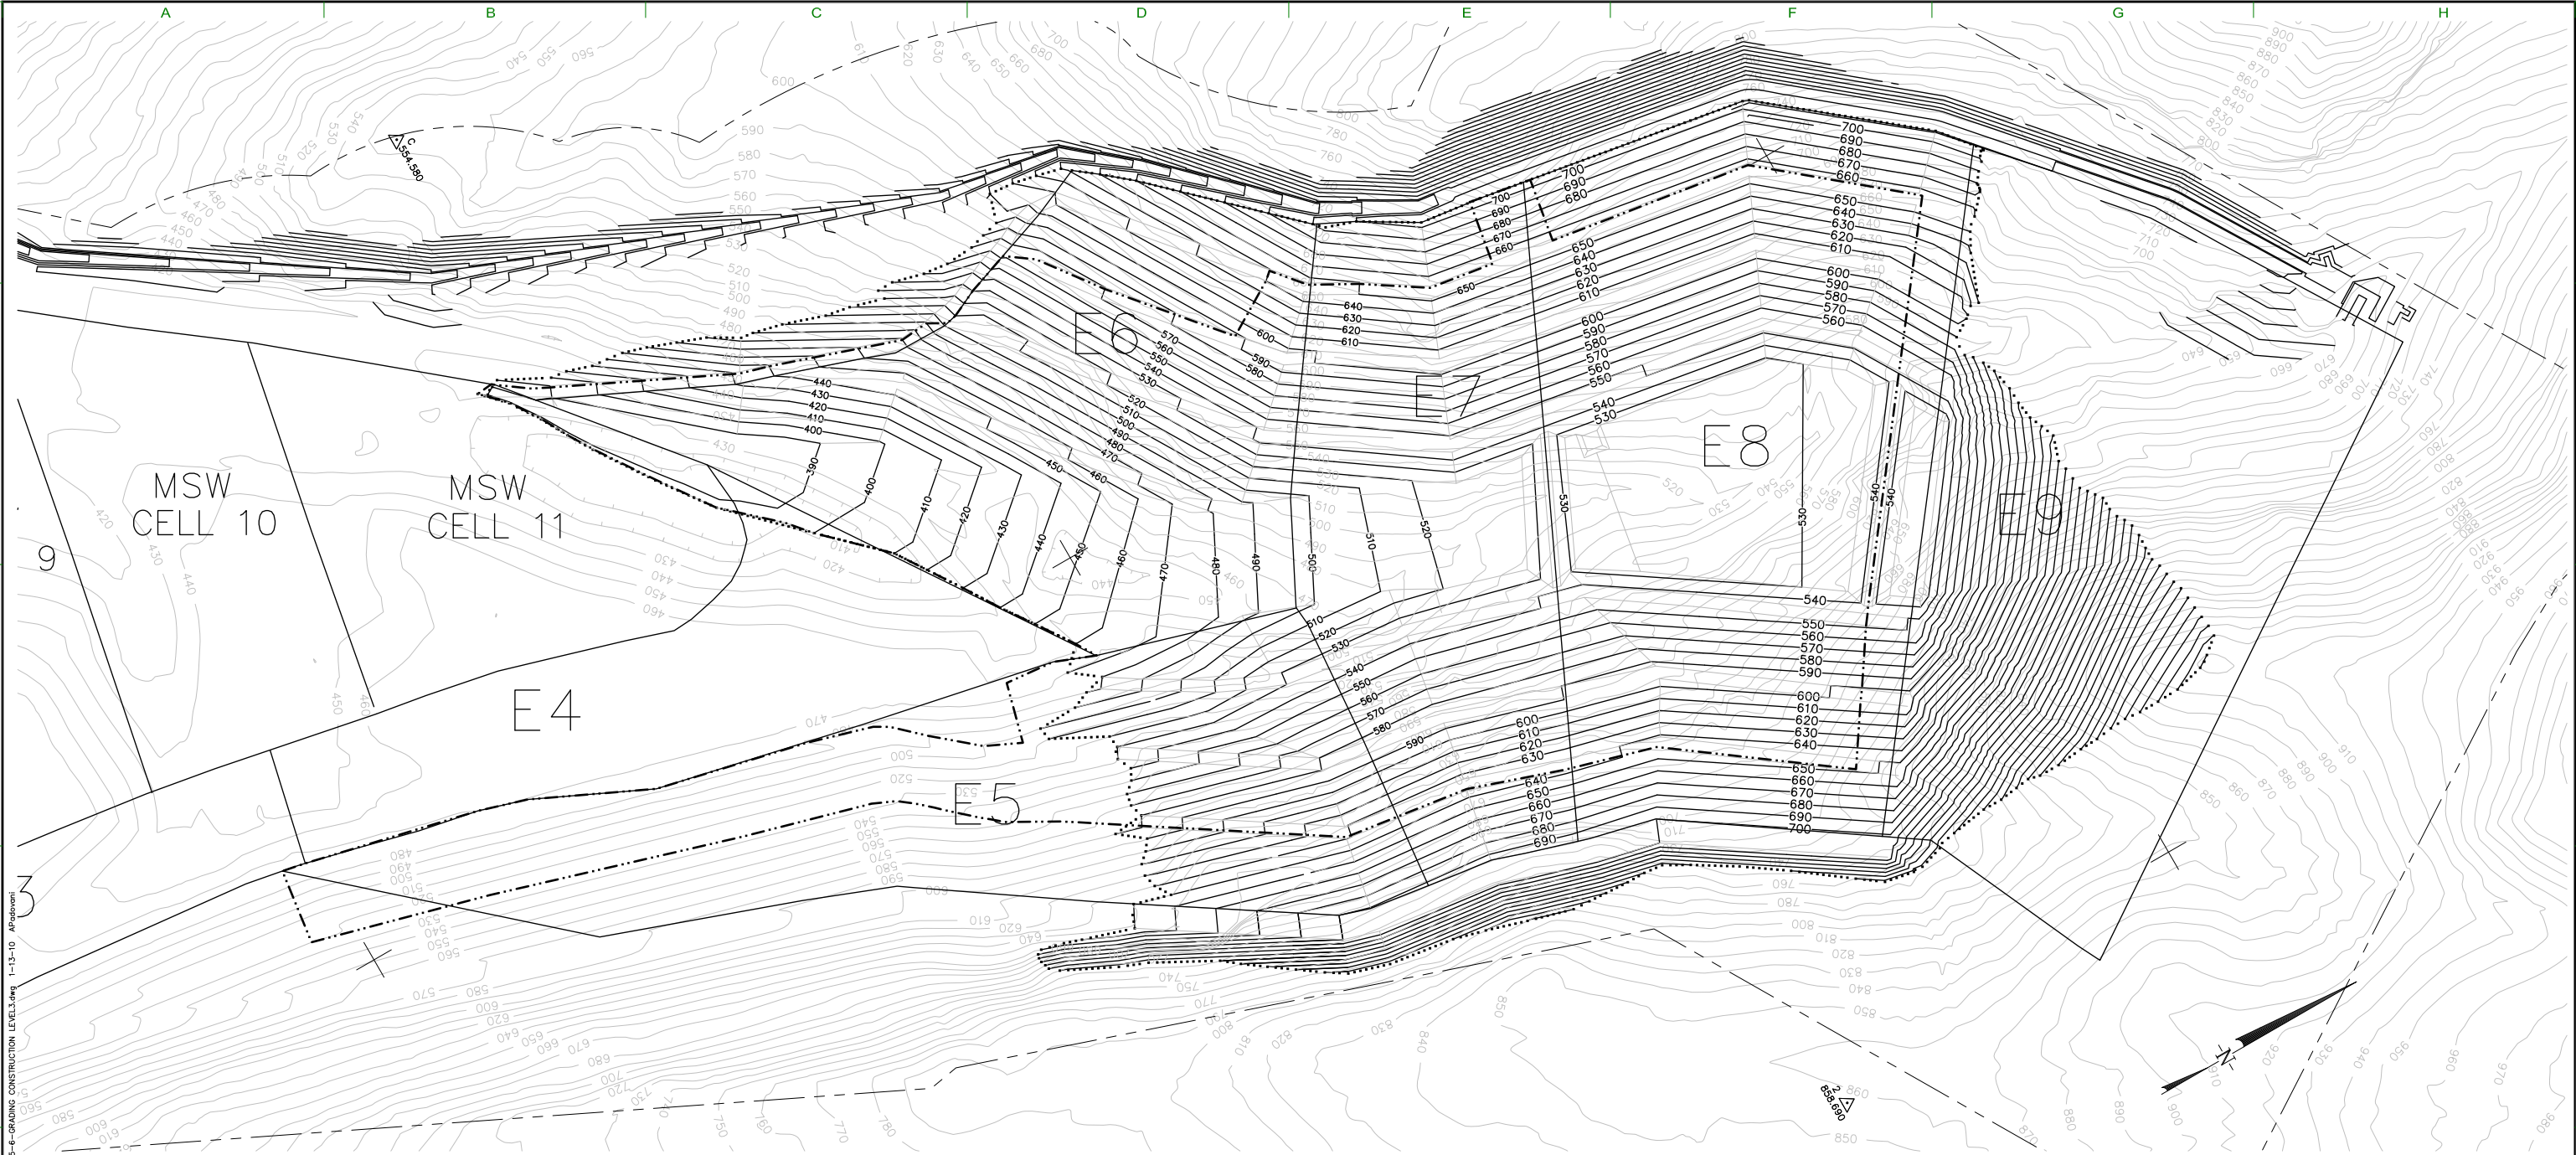

NOTES:


- EXISTING TOPOGRAPHY BASED ON 16 MARCH 2009 AERIAL SURVEY PROVIDED BY OWNER. WASTE ELEVATIONS MAY VARY.
- THE LOCATION OF TIE-IN TO EXISTING LINER SHOWN IS APPROXIMATE. ACTUAL LOCATION OF TIE-IN SHOULD BE FIELD VERIFIED PRIOR TO CONSTRUCTION AND MAY VARY FROM LAYOUT SHOWN. CONTRACTOR TO FIELD LOCATE AND UNCOVER EXISTING LINER SYSTEM TERMINATION, AND EXTEND AND CONNECT NEW LINER SYSTEM COMPONENTS TO EXISTING AS NECESSARY TO MAINTAIN LINER SYSTEM CONTINUITY.
- GRADES ALONG TIE-IN MAY BE ADJUSTED AS NEEDED TO MATCH EXISTING SUBGRADE CONDITIONS WITH APPROVAL BY THE ENGINEER.
- FOR VEHICULAR TRAFFIC ON LINER SYSTEM, MINIMUM ALLOWABLE GROUND PRESSURES AND COVER MATERIAL REQUIREMENTS IN THE SPECIFICATIONS TO BE FOLLOWED AT ALL TIMES DURING AND AFTER CONSTRUCTION.
- BEFORE, DURING, AND AFTER STORM EVENTS, CONTRACTOR TO CONTROL AND DIRECT SURFACE WATER RUNOFF BY PUMPING OR OTHER METHODS. CONTRACTOR TO COORDINATE WITH OWNER FOR EROSION CONTROL METHODS.
- EXISTING CONCRETE CHANNEL (INCLUDING WINGWALLS AND HEADWALL) AND EXISTING 48" Ø PIPES TO BE REMOVED WITHIN THIS AREA, PRIOR TO SUBGRADE PREPARATION OF CELL E6.
- BENCHES THAT WILL NOT RECEIVE LINER SHALL BE LOCALLY GRADED SO THAT WATER FLOWS AWAY FROM LANDFILL.
- IF COLLUVIUM OR ALLUVIUM ARE ENCOUNTERED DURING EXCAVATION, SLOPES SHALL BE RE-EVALUATED AND MAY NEED TO BE FLATTENED.
- A SUBDRAIN PIPE MAY BE REQUIRED TO COLLECT SEEPS. SEEPS TO BE IDENTIFIED BY A GEOLOGIST. SUBDRAIN PIPE MAY NEED TO BE EXTENDED PAST THE LIMITS CURRENTLY SHOWN.
- SLOPES SHALL BE EXCAVATED FROM TOP DOWN. CONTRACTOR SHALL ALLOW A GEOLOGIST TO ACCESS THE EXCAVATED SLOPES FOR GEOLOGIC MAPPING AND TO CONFIRM THAT THE SLOPES WILL BE STABLE.

NOTES (CONT.):

- RISER PIPES SHALL BE EXTENDED AS WEST BERM IS CONSTRUCTED.
- AREA OF INCREASED GRAVEL THICKNESS SHOWN ON SHEET 4.
- EXCAVATION FOR SUMP AREA AND ITS VICINITY WILL REQUIRE SPECIAL PROVISIONS; THEREFORE COORDINATION WITH OWNER/OPERATOR WILL BE REQUIRED.**
- A MINIMUM OF THREE DAYS BEFORE STARTING CONSTRUCTION AND AS PART OF MOBILIZATION, CONTRACTOR WITH OWNER/OPERATOR SHALL CLEARLY MARK/IDENTIFY THE LOCATION OF EXISTING UTILITIES AND/OR FACILITIES. EXISTING UTILITIES MAY BE OVERHEAD, ABOVE-GROUND, OR BURIED. EXISTING UTILITIES INCLUDE, BUT ARE NOT LIMITED TO, OVERHEAD POWER LINES AND EXISTING FOUNDATIONS; GROUNDWATER MONITORING WELLS; LANDFILL GAS PROBES; LANDFILL GAS WELLS; SURFACE WATER SAMPLING LOCATIONS; LANDFILL GAS, LANDFILL CONDENSATE, AND LEACHATE PIPELINES; SURFACE CONTROL PIPES; ETC. COORDINATION WITH LOCAL UTILITIES AND/OR A PRIVATE UTILITY LOCATION SERVICE MAY BE REQUIRED.
- LOCATION OF EXISTING UTILITIES SHALL BE CLEARLY MARKED BY FLAGGED 4-FT HIGH WOODEN STAKES AT 100-FT INTERVALS AND PAINT ON THE GROUND SURFACE. NEARER INTERVALS MAY BE REQUIRED BASED ON FIELD CONDITIONS. CONTRACTOR SHALL MONITOR AND MAINTAIN THE MARKINGS DURING THE CONSTRUCTION PROJECT UNTIL FINAL ACCEPTANCE OF THE WORK BY THE OWNER/OPERATOR.
- CONTRACTOR SHALL FOLLOW ALL APPLICABLE CITY, STATE AND FEDERAL HEALTH AND SAFETY REQUIREMENTS TO GUARD AND PROTECT ALL WORKERS, PEDESTRIANS, AND THE PUBLIC FROM EXCAVATIONS, BLASTING OPERATIONS, CONSTRUCTION EQUIPMENT, TRAFFIC, CONSTRUCTION OPERATIONS, ALL OBSTRUCTIONS, AND OTHER DANGEROUS ITEMS (E.G., LANDFILL GAS) OR AREAS. A HEALTH AND SAFETY PLAN IS REQUIRED AS PART OF THE WORK.
- EXPECTED TO BE CONSTRUCTED BETWEEN 2010 AND 2014.
- LIMIT OF FUTURE WASTE FILL IN CELLS E5 THROUGH E8 MAY CHANGE DEPENDING ON FUTURE WASTE STREAM.

LEGEND

- 480 CELLS E5 THROUGH E8 BASE GRADE 10-FT CONTOUR (MSL)
- 800 EXISTING GROUND 10-FT CONTOUR (MSL)
- 4 286.16 EXISTING BENCHMARK
- CELL BOUNDARY/LIMIT OF FUTURE WASTE FILL (NOTE 17)
- PROPERTY LINE
- APPROXIMATE LIMIT OF EARTHWORK
- APPROXIMATE CELLS E5 THROUGH E8 LINER LIMIT (NOTE 16)

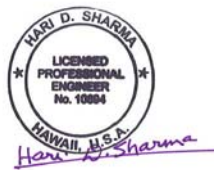

REVISIONS			
NO.	DESCRIPTION	DATE	BY



Geosyntec  
consultants

475 14th Street  
Suite 400  
Oakland, CA 94612

CELL BOUNDARIES AND  
PROPOSED LINER LIMIT

CELLS E5 THROUGH E8  
WAIMANALO GULCH LANDFILL  
EWA BEACH, OAHU, HAWAII

CONSTRUCTION DRAWINGS

DES BY: ACP	DATE: JANUARY 2010
DRN BY: ACP	SCALE: AS SHOWN
CHK BY: FWS	PROJECT: WL0770
REV BY: HDS	DOCUMENT:
APP BY: HDS	FILE:

SHEET NO.

23



QQ  
4 PLAN  
CELL E8 LCRS SUMP

LEGEND

- 530— CELL E8 BASE GRADE 10-FT CONTOUR (MSL)
- 526— CELL E8 BASE GRADE 2-FT CONTOUR (MSL)
- CELL E8 BASE GRADE GRADEBREAK
- EXISTING GROUND 10-FT CONTOUR (MSL)
- CELL BOUNDARY

NOTES:

1. FOR VEHICULAR TRAFFIC ON LINER SYSTEM, MINIMUM ALLOWABLE GROUND PRESSURES AND COVER MATERIAL REQUIREMENTS IN THE SPECIFICATIONS TO BE FOLLOWED AT ALL TIMES DURING AND AFTER CONSTRUCTION.
2. BEFORE, DURING, AND AFTER STORM EVENTS, CONTRACTOR TO CONTROL AND DIRECT SURFACE WATER RUNOFF BY PUMPING OR OTHER METHODS. CONTRACTOR TO COORDINATE WITH OWNER FOR EROSION CONTROL METHODS.
3. GRADES SHOWN ARE FOR TOP OF SUBGRADE.
4. PIPE MATERIAL SHALL BE HDPE OR FRP.

SCHEDULE OF CONTROL POINTS			
POINT	NORTHING	EASTING	ELEVATION (FT)
9000	71621.59	459181.33	524.96
9001	71615.84	459212.04	525.19
9002	71648.59	459217.67	525.19
9003	71653.44	459186.81	524.96
9004	71626.88	459186.93	521.88
9005	71623.49	459206.64	521.88
9006	71643.20	459210.03	521.88
9007	71646.59	459190.32	521.88
9008	71632.33	459214.23	524.87



REVISIONS			
NO.	DESCRIPTION	DATE	BY



Geosyntec  
consultants

475 14th Street  
Suite 400  
Oakland, CA 94612

CELL E8 SUMP

CELLS E5 THROUGH E8  
WAIMANALO GULCH LANDFILL  
EWA BEACH, OAHU, HAWAII


CONSTRUCTION DRAWINGS

DES BY: FWS	DATE: FEBRUARY 2010
DRN BY: LKH	SCALE: AS SHOWN
CHK BY: FWS	PROJECT: WL0770
REV BY: HDS	DOCUMENT:
APP BY: HDS	FILE:

SHEET NO.  
24



P:\CADD\Land Projects 3\WMA\Waimanalo\dwg\Cells E5-E6 and Partial West Berm Construction\West Berm Buttress-Grading.dwg 3-11-10 02:05:16 PM APadovani

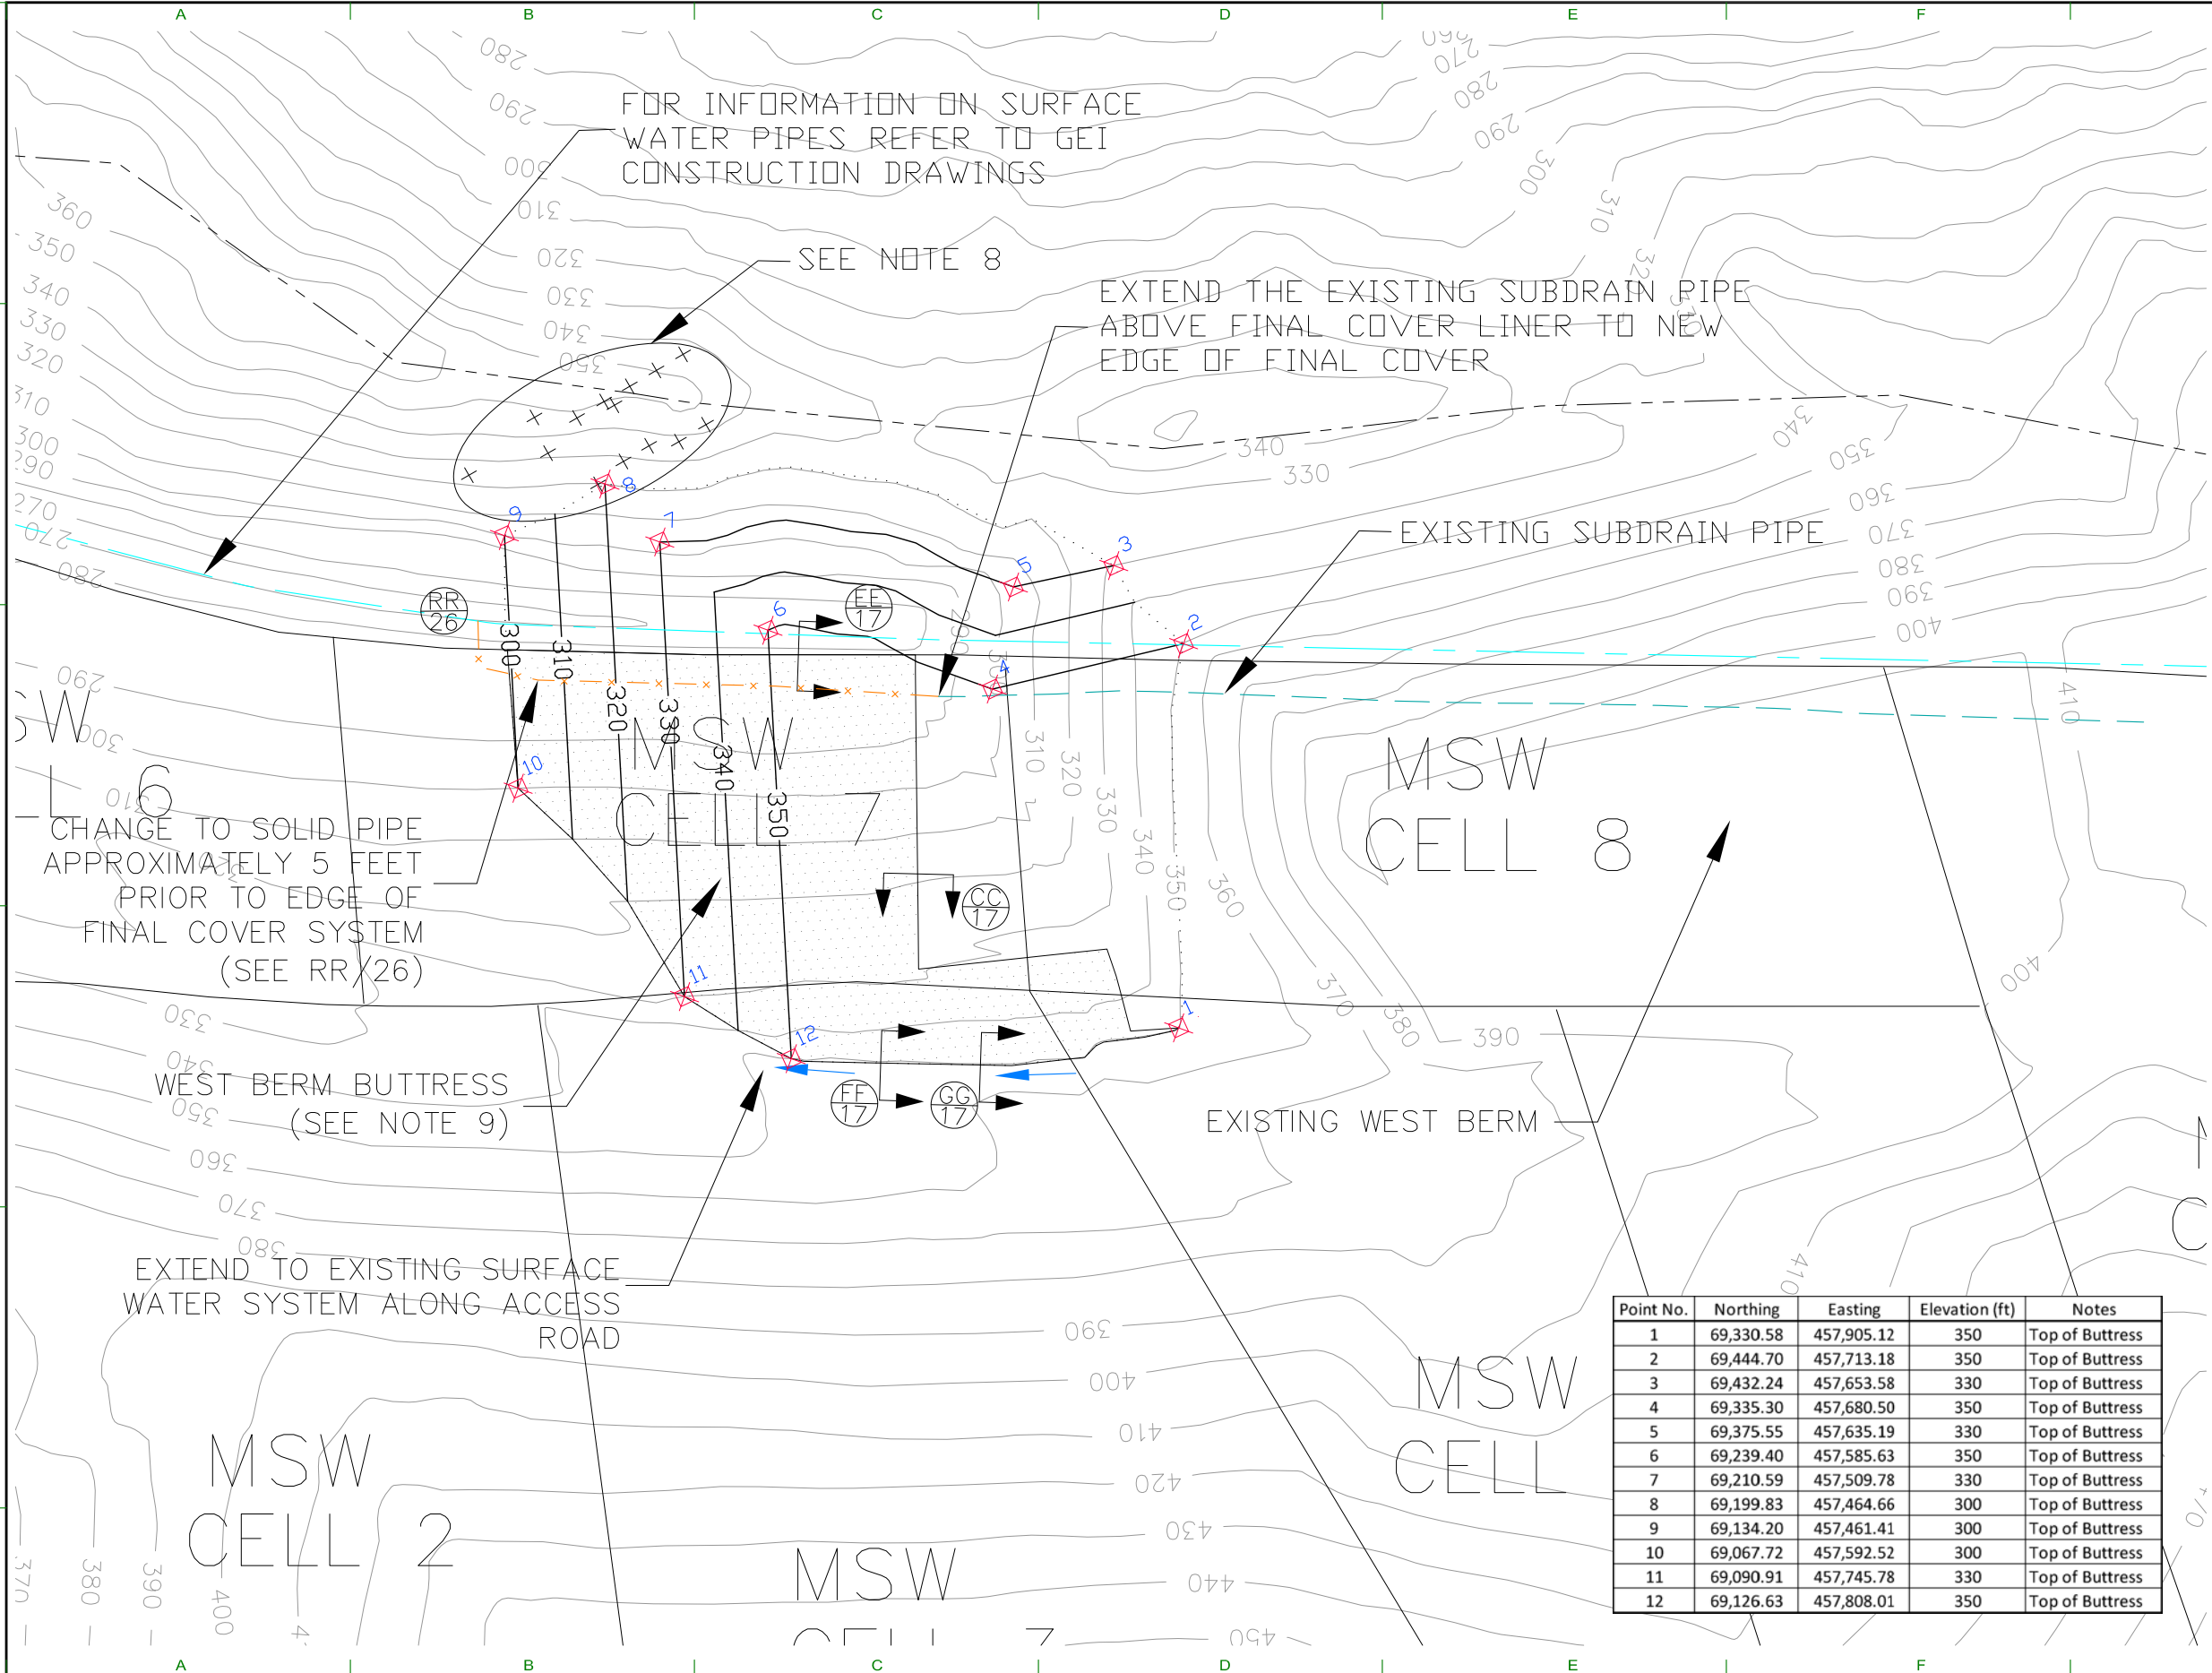

**LEGEND**

- 440 WEST BERM BUTTRESS 10-FT CONTOUR (MSL)
- AREA TO BE CLOSED PRIOR TO WEST BERM BUTTRESS PLACEMENT
- 800 EXISTING GROUND 10-FT CONTOUR (MSL)
- CELL BOUNDARY
- NEW SURFACE WATER PIPES (SEE GEI CONSTRUCTION DRAWINGS)
- PROPERTY LINE
- APPROXIMATE LIMIT OF EARTHWORK
- EXISTING SUBDRAIN PIPE
- SURFACE WATER FLOW DIRECTION
- APPROXIMATE LOCATION OF SUBDRAIN PIPE EXTENSION (PERFORATED AND SOLID)
- CONTROL POINTS (SEE TABLE BELOW)



- NOTES:**
- EXISTING TOPOGRAPHY BASED ON 16 MARCH 2009 AERIAL SURVEY PROVIDED BY OWNER.
  - THE LOCATION OF TIE-IN TO EXISTING LINER SHOWN IS APPROXIMATE. ACTUAL LOCATION OF TIE-IN SHOULD BE FIELD VERIFIED PRIOR TO CONSTRUCTION AND MAY VARY FROM LAYOUT SHOWN. CONTRACTOR TO FIELD LOCATE AND UNCOVER EXISTING LINER SYSTEM TERMINATION, AND EXTEND AND CONNECT NEW LINER SYSTEM COMPONENTS TO EXISTING AS NECESSARY TO MAINTAIN LINER SYSTEM CONTINUITY.
  - GRADES ALONG TIE-IN MAY BE ADJUSTED AS NEEDED TO MATCH EXISTING SUBGRADE CONDITIONS WITH APPROVAL BY THE ENGINEER.
  - FOR VEHICULAR TRAFFIC ON LINER SYSTEM, MINIMUM ALLOWABLE GROUND PRESSURES AND COVER MATERIAL REQUIREMENTS IN THE SPECIFICATIONS TO BE FOLLOWED AT ALL TIMES DURING AND AFTER CONSTRUCTION.
  - BEFORE, DURING, AND AFTER STORM EVENTS DURING CONSTRUCTION, CONTRACTOR TO CONTROL AND DIRECT SURFACE WATER RUNOFF BY PUMPING OR OTHER METHODS. CONTRACTOR TO COORDINATE WITH OWNER FOR EROSION CONTROL METHODS.
  - A MINIMUM OF THREE DAYS BEFORE STARTING CONSTRUCTION AND AS PART OF MOBILIZATION, CONTRACTOR WITH OWNER/OPERATOR SHALL CLEARLY MARK/IDENTIFY THE LOCATION OF EXISTING UTILITIES AND/OR FACILITIES. EXISTING UTILITIES MAY BE OVERHEAD, ABOVE-GROUND, OR BURIED. EXISTING UTILITIES INCLUDE, BUT ARE NOT LIMITED TO, OVERHEAD POWER LINES AND EXISTING FOUNDATIONS; GROUNDWATER MONITORING WELLS; LANDFILL GAS PROBES; LANDFILL GAS WELLS; SURFACE WATER SAMPLING LOCATIONS; LANDFILL GAS, LANDFILL CONDENSATE, AND LEACHATE PIPELINES; SURFACE CONTROL PIPES; ETC. COORDINATION WITH LOCAL UTILITIES AND/OR A PRIVATE UTILITY LOCATION SERVICE MAY BE REQUIRED. LOCATION OF EXISTING UTILITIES SHALL BE CLEARLY MARKED BY FLAGGED 4-FT HIGH WOODEN STAKES AT 100-FT INTERVALS AND PAINT ON THE GROUND SURFACE. NEARER INTERVALS MAY BE REQUIRED BASED ON FIELD CONDITIONS. CONTRACTOR SHALL MONITOR AND MAINTAIN THE MARKINGS DURING THE CONSTRUCTION PROJECT UNTIL FINAL ACCEPTANCE OF THE WORK BY THE OWNER/OPERATOR.
  - CONTRACTOR SHALL FOLLOW ALL APPLICABLE CITY, STATE AND FEDERAL HEALTH AND SAFETY REQUIREMENTS TO GUARD AND PROTECT ALL WORKERS, PEDESTRIANS, AND THE PUBLIC FROM EXCAVATIONS, BLASTING OPERATIONS, CONSTRUCTION EQUIPMENT, TRAFFIC, CONSTRUCTION OPERATIONS, ALL OBSTRUCTIONS, AND OTHER DANGEROUS ITEMS (E.G., LANDFILL GAS) OR AREAS. A HEALTH AND SAFETY PLAN IS REQUIRED AS PART OF THE WORK.
  - CONTRACTOR SHALL BE AWARE OF EXISTING GUY WIRES FOR HECO POWERLINES.
  - WEST BERM BUTTRESS SHALL BE CONSTRUCTED IN GENERAL ACCORDANCE WITH SECTION 02211 OF THE SPECIFICATIONS.

Point No.	Northing	Easting	Elevation (ft)	Notes
1	69,330.58	457,905.12	350	Top of Buttress
2	69,444.70	457,713.18	350	Top of Buttress
3	69,432.24	457,653.58	330	Top of Buttress
4	69,335.30	457,680.50	350	Top of Buttress
5	69,375.55	457,635.19	330	Top of Buttress
6	69,239.40	457,585.63	350	Top of Buttress
7	69,210.59	457,509.78	330	Top of Buttress
8	69,199.83	457,464.66	300	Top of Buttress
9	69,134.20	457,461.41	300	Top of Buttress
10	69,067.72	457,592.52	300	Top of Buttress
11	69,090.91	457,745.78	330	Top of Buttress
12	69,126.63	457,808.01	350	Top of Buttress



REVISIONS			
NO.	DESCRIPTION	DATE	BY



**Geosyntec**  
consultants

**475 14th Street  
Suite 400  
Oakland, CA 94612**

**WEST BERM BUTTRESS**

WEST BERM BUTTRESS  
WAIMANALO GULCH LANDFILL  
EWA BEACH, OAHU, HAWAII


**CONSTRUCTION DRAWINGS**

DES BY: ACP	DATE: MARCH 2010
DRN BY: ACP	SCALE: AS SHOWN
CHK BY: FWS	PROJECT: WL0770
REV BY: HDS	DOCUMENT:
APP BY: HDS	
FILE:	

SHEET NO.

**25**

P:\CADD\Land Projects\3\WMA\Waimanalo\Cell E5-E8 and Partial West Berm Construction\Cell E5-E8-Details Construction Level\_REV.dwg 3-11-10 CWing

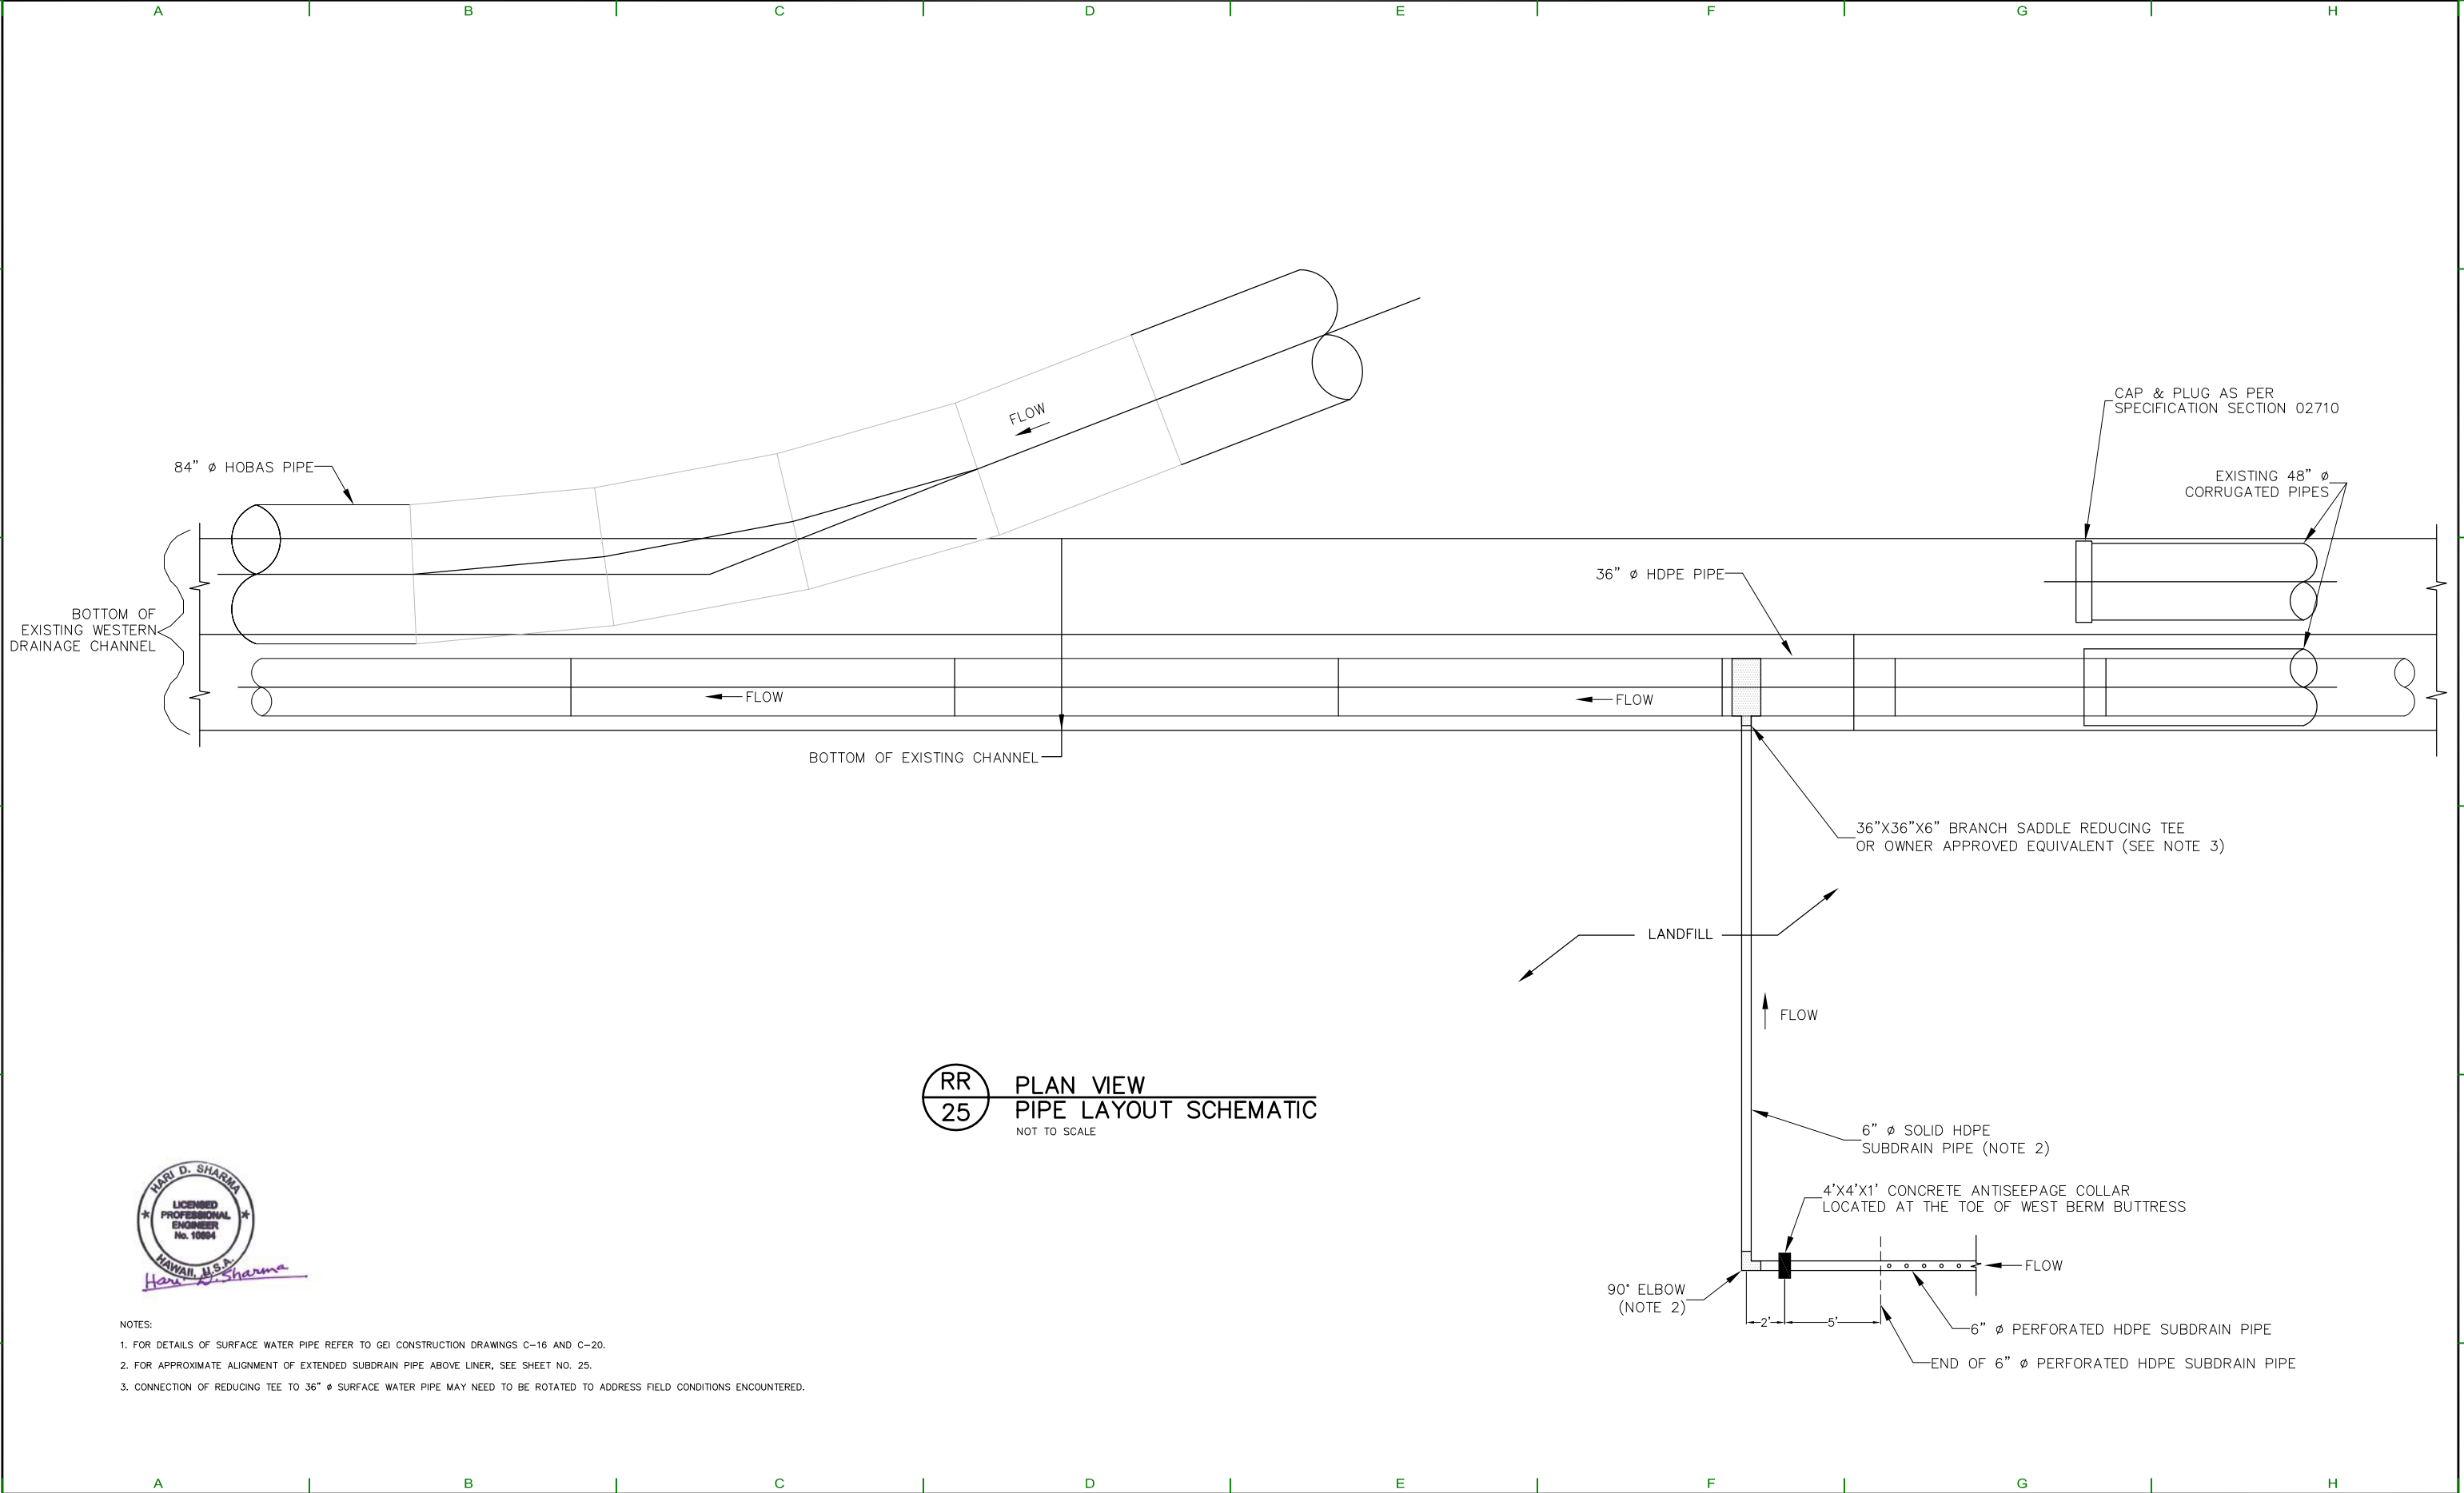

- NOTES:
1. FOR DETAILS OF SURFACE WATER PIPE REFER TO GEI CONSTRUCTION DRAWINGS C-16 AND C-20.
  2. FOR APPROXIMATE ALIGNMENT OF EXTENDED SUBDRAIN PIPE ABOVE LINER, SEE SHEET NO. 25.
  3. CONNECTION OF REDUCING TEE TO 36"  $\phi$  SURFACE WATER PIPE MAY NEED TO BE ROTATED TO ADDRESS FIELD CONDITIONS ENCOUNTERED.

REVISIONS			
NO.	DESCRIPTION	DATE	BY
	ADDED DRAWING	11 MAR 10	



Geosyntec  
consultants

475 14th Street  
Suite 400  
Oakland, CA 94612

SCHEMATIC PLAN VIEW OF  
SURFACE WATER PIPES

CELLS E5 THROUGH E8  
WAIMANALO GULCH LANDFILL  
EWA BEACH, OAHU, HAWAII

CONSTRUCTION DRAWINGS			
DES BY: FWS	DATE: MARCH 2010		
DRN BY: CAW	SCALE: AS SHOWN		
CHK BY: FWS	PROJECT: WL0770		
REV BY: HDS	DOCUMENT:		
APP BY: HDS	FILE:		

SHEET NO.  
26